


T.12S.R. 9W.W.M.

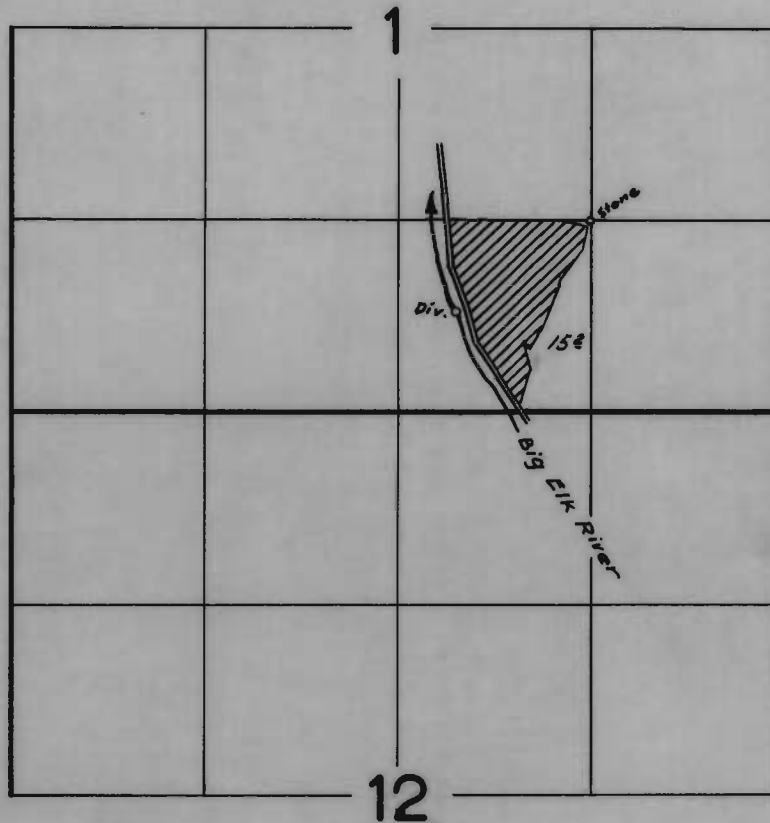

FINAL PROOF SURVEY
UNDER

Application No. 24837. Permit No. 19552.
IN NAME OF

S. H. DODSON

Surveyed 28 April 1959, by R. H. Jackson