


T.33S.R.2E.W.M.

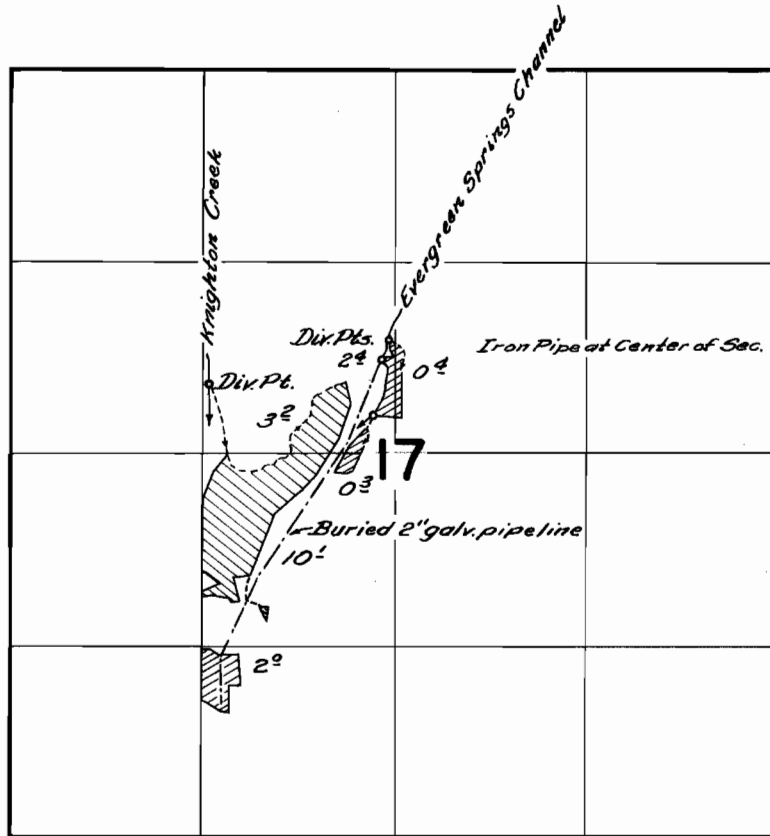

FINAL PROOF SURVEY UNDER

Application No. 25414 Permit No. 19898
IN NAME OF

Marcus Dey

Surveyed *May 6, 1959* by *C.O. Bactels*