


T.13 & 14 S. R.1 E. W.M.

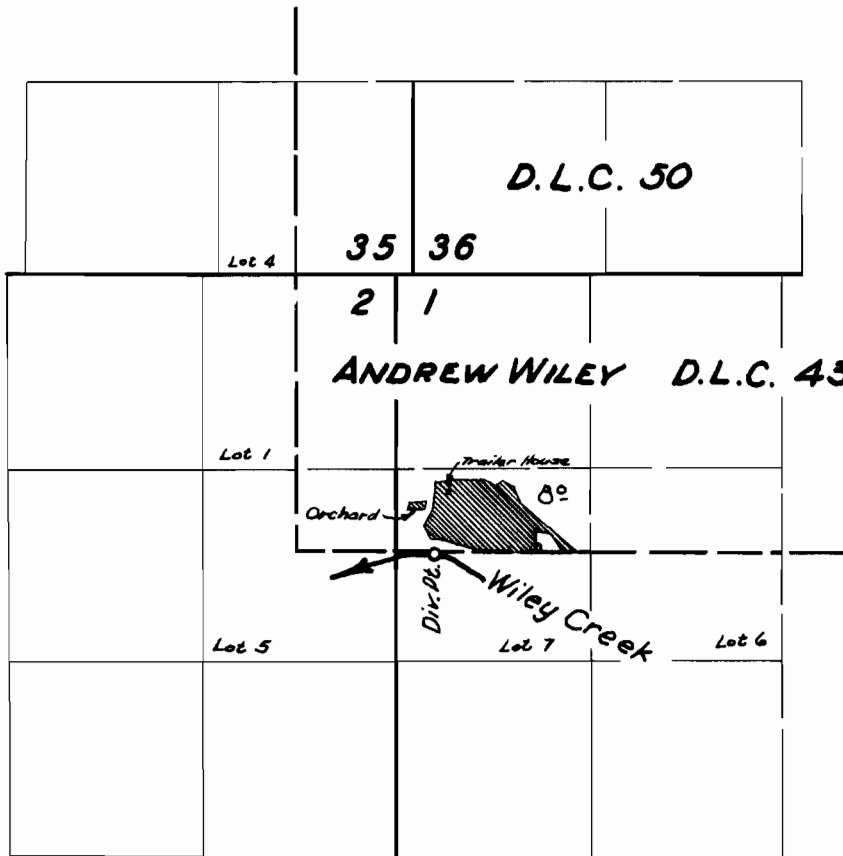

**FINAL PROOF SURVEY**  
UNDER

Application No. 25441 .. Permit No. 19905 ..  
IN NAME OF

**WALTER & BETTY JO FORSBERG**

Surveyed 9 Sept. 1958, by C.O. Bartels..