


T.11 & 12 S.R.6W.W.M.

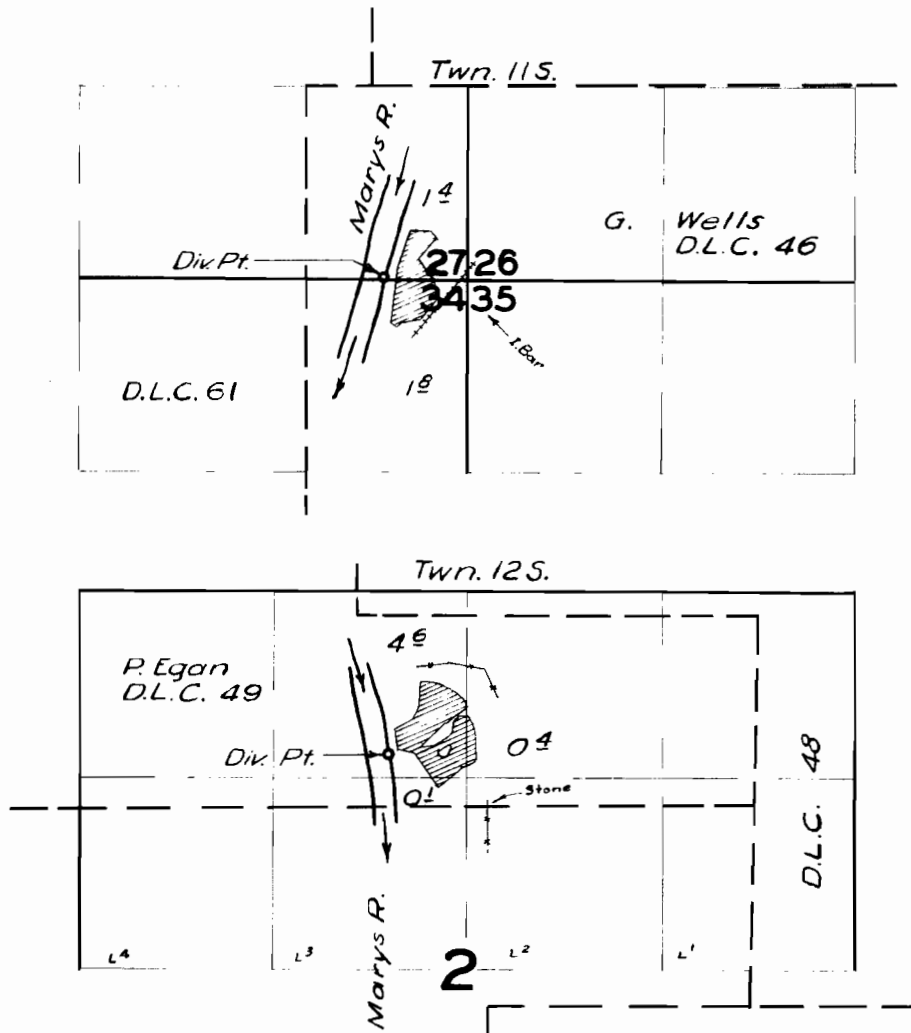

FINAL PROOF SURVEY UNDER

Application No. 26041 Permit No. 20384
IN NAME OF

EDWARD C. HOWARD

Surveyed 3 April 1959, by *M. A. Sech*