


# T. 4 S. R. 5 W. W.M.

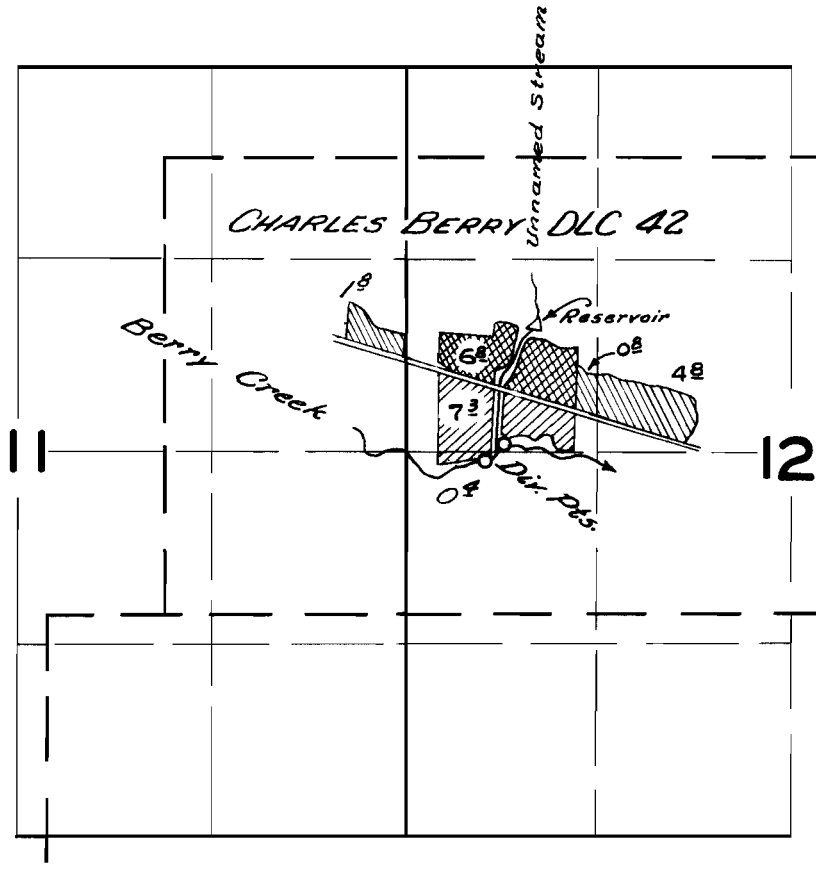

Berry Creek   
Unnamed Stream 

## FINAL PROOF SURVEY UNDER

Application No. 26054 Permit No. 20563  
IN NAME OF

CARTER & DONALD L. KVAVLE

Surveyed May 1, 1958, by M. Bisk