


T.12S. R.1W.W.M.

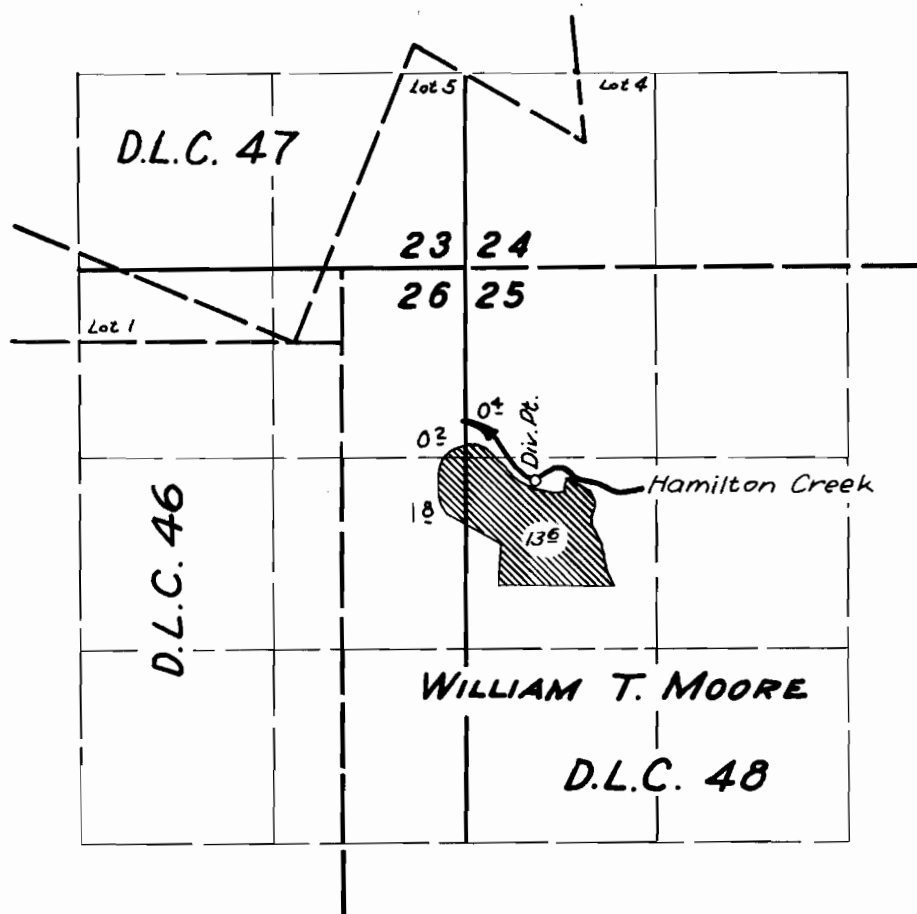

FINAL PROOF SURVEY
UNDER

Application No. 26537... Permit No. 20795...
IN NAME OF

AVIS V. HILL

Surveyed 12 Sept. 1958, by C.O. Bartels...