


T.35S. R.1W.W.M.

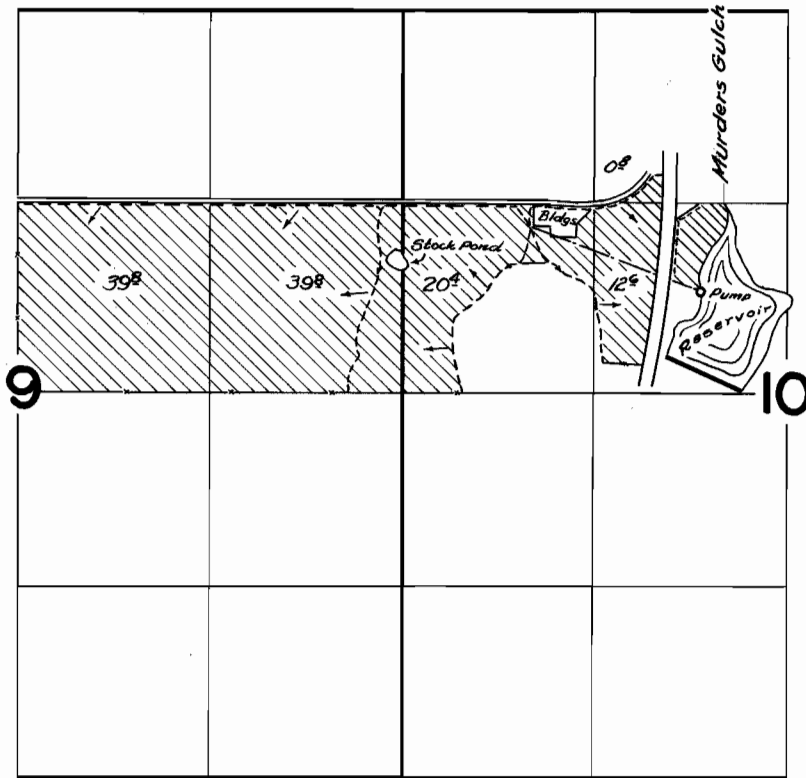

**FINAL PROOF SURVEY**  
UNDER

Application No. *26585* *21011*  
*26771* *21035*  
*R.30896* *R.1893*  
*30897* *24330*  
Application No. *31255* Permit No. *24625*  
IN NAME OF

*Phillip Nevins*

Surveyed *May 7* 1959, by *C.O. Bartels*