


T.35S. R.1W.W.M.

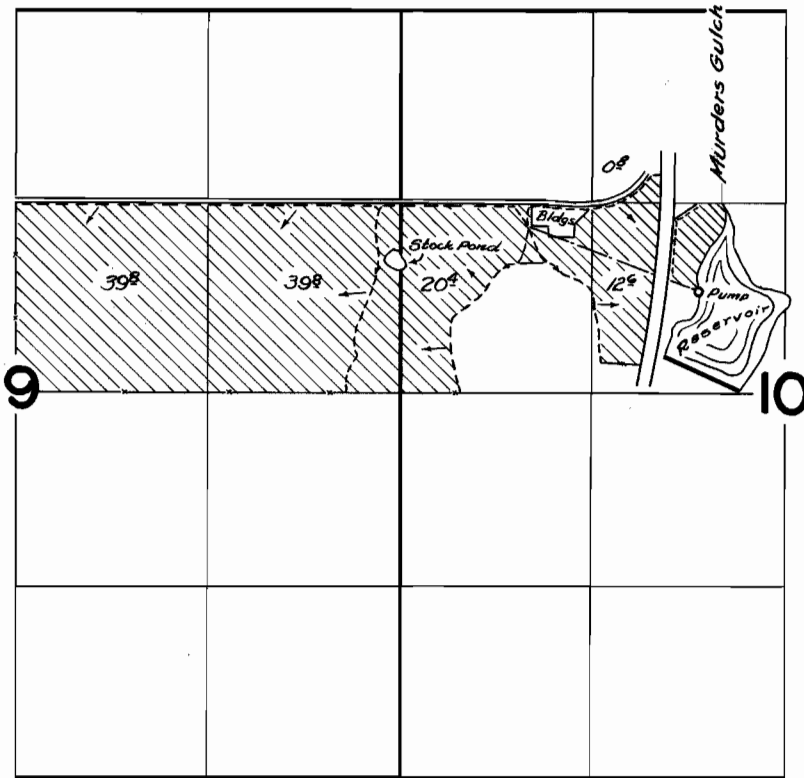

FINAL PROOF SURVEY
UNDER

Application No. *26585* *21011*
26771 *21035*
R.30896 *R.1893*
30897 *24330*
Application No. *31255* Permit No. *24625*
IN NAME OF

Phillip Nevins

Surveyed *May 7* 1959, by *C.O. Bartels*