


T.12S. R.2 W.W.M.

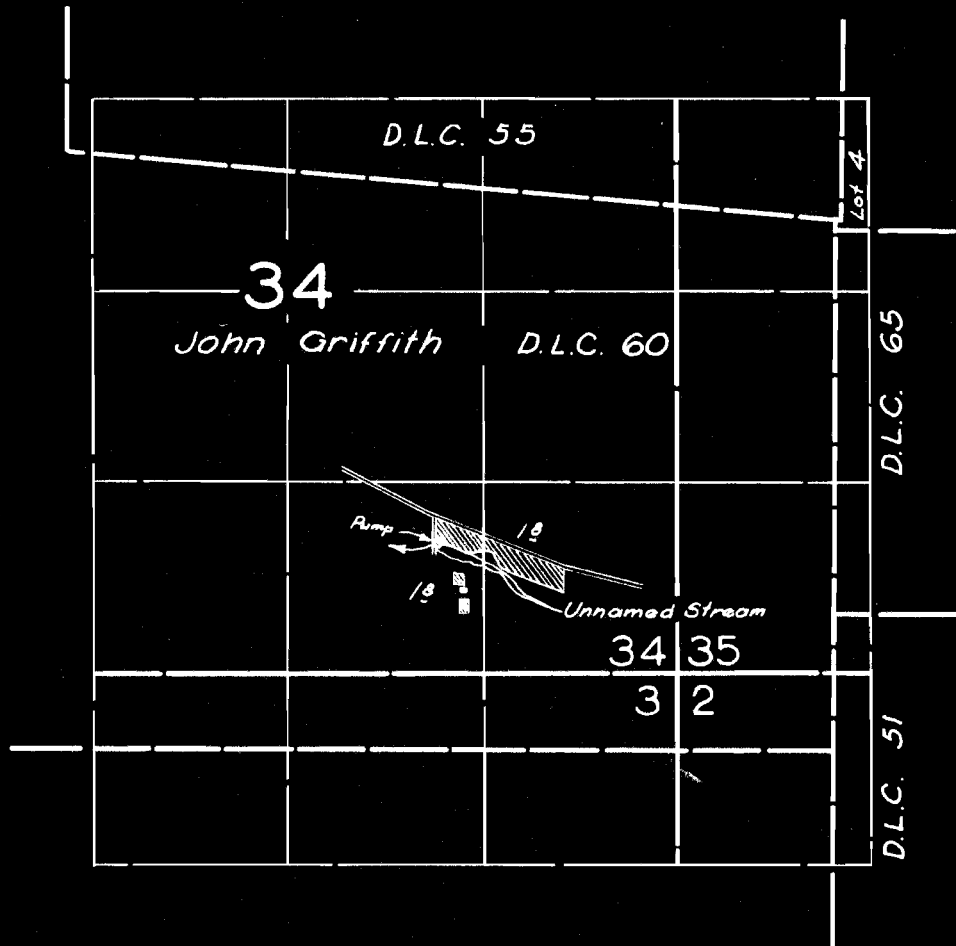

**FINAL PROOF SURVEY**  
UNDER

R-26808 R-1322  
Application No. 26809 Permit No. 21055  
IN NAME OF

*LESTER O. GROW*

Surveyed 4 June 1959, by *R.H. Jackson*