


T.12S. R.2 W.W.M.

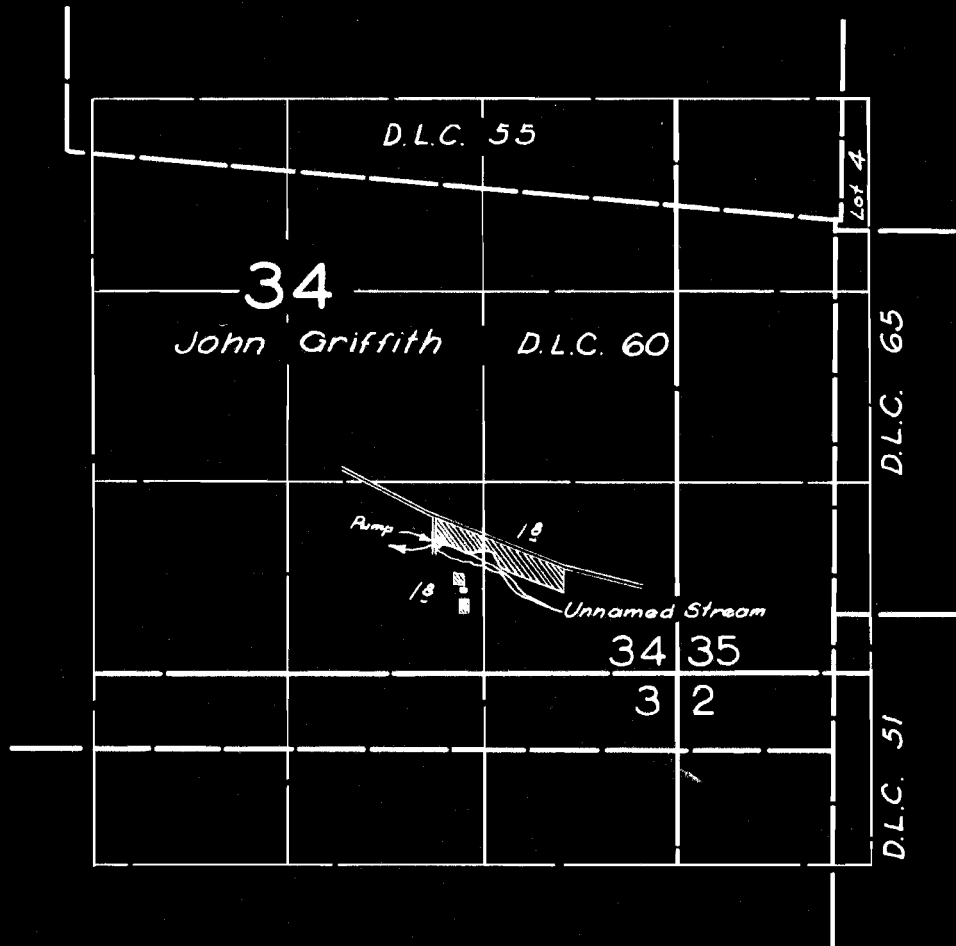

FINAL PROOF SURVEY
UNDER

R-26808 R-1322
Application No. 26809 Permit No. 21055
IN NAME OF

LESTER O. GROW

Surveyed 4 June 1959, by *R.H. Jackson*