


T. 9 S. R. 10 W. W. M.

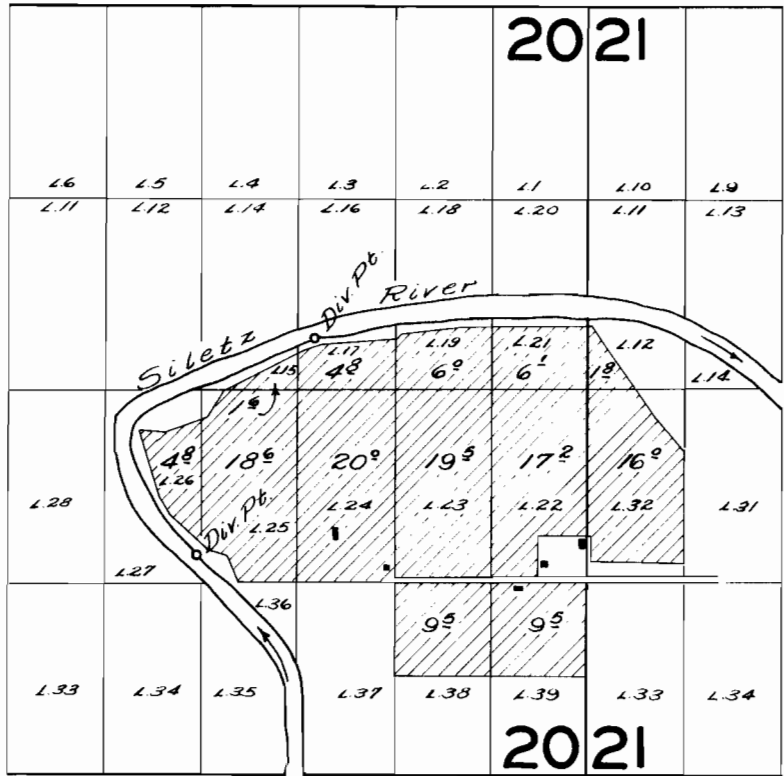

FINAL PROOF SURVEY UNDER

Application No. 26850 Permit No. 21086
IN NAME OF

MIKE MILLER

Surveyed *APRIL 17* 1959, by *C. O. Bartels*