


T.33S. R.1W.W.M.

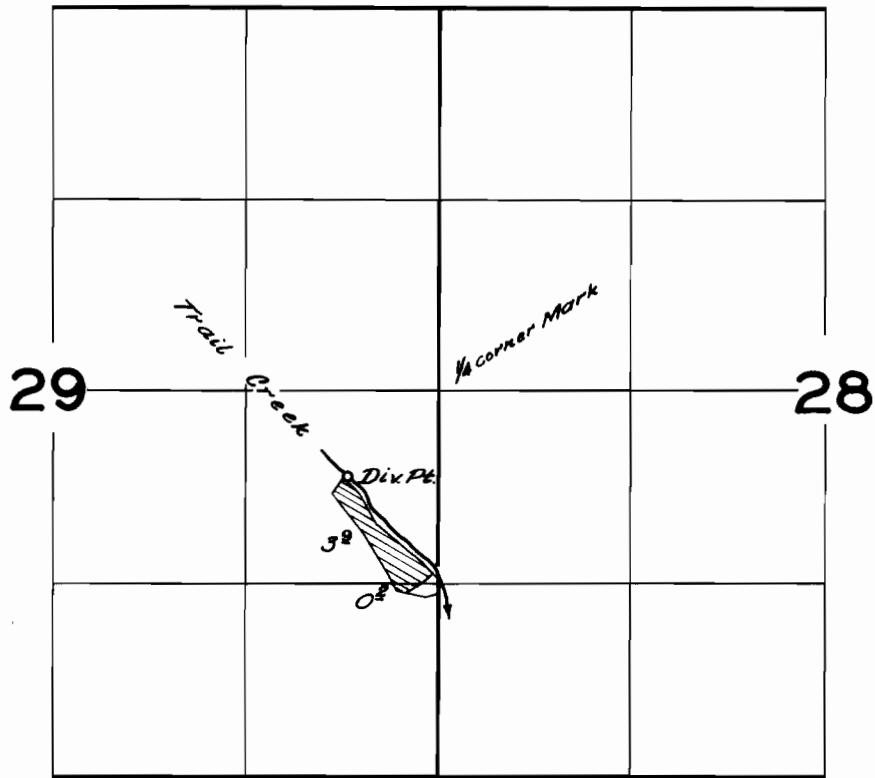

FINAL PROOF SURVEY
UNDER

Application No. 21003... Permit No. 21209...
IN NAME OF

.....ORAGE O. HOUSTON.....

Surveyed MAY 6... 1959, by *W. B. Smith*.....