


T.13S. R.1W.W.M.

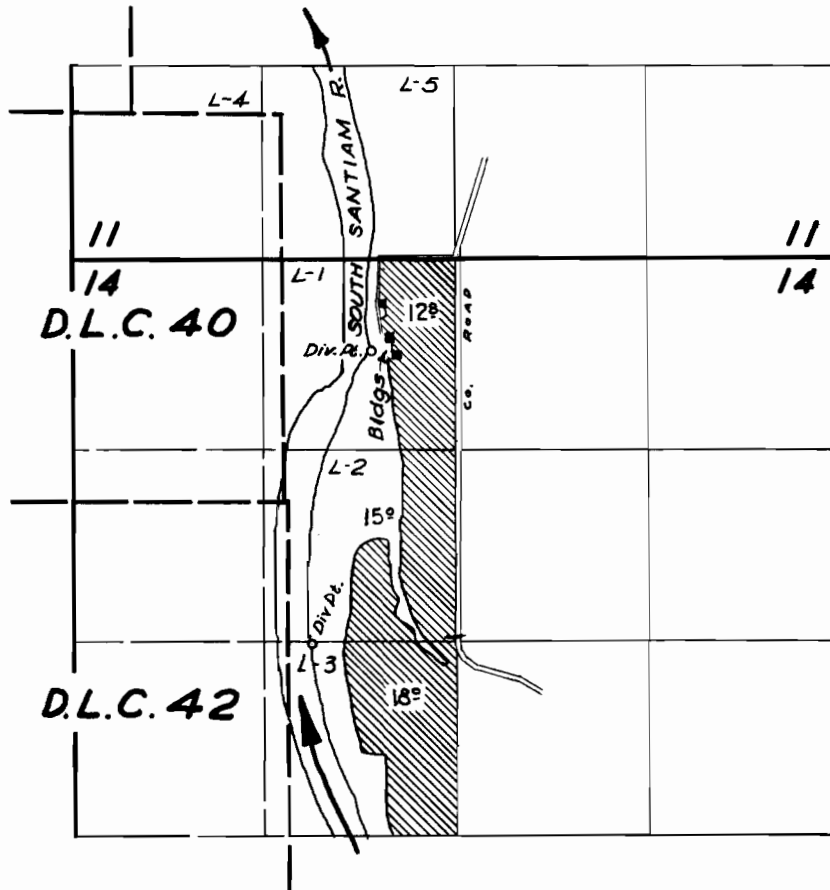

FINAL PROOF SURVEY
UNDER

Application No. 27155... Permit No. 21356..
IN NAME OF

GUY & FRANCES N. BABCOCK

Surveyed 4. Sept. 1958, by C.O. Bartels