


T.11S. R.8 W.W.M.

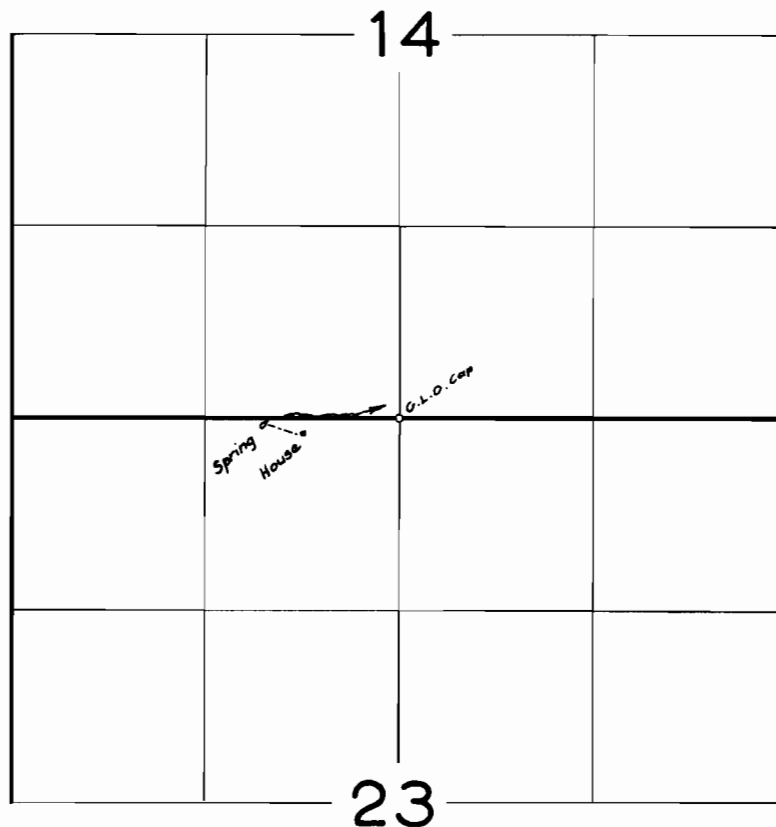

FINAL PROOF SURVEY
UNDER

Application No. 25492 Permit No. 21505
IN NAME OF

NORMAN BENNETT

Surveyed 1 May 1959, by *R. Jackson*