


T.6 S.R.1 E.W.M.

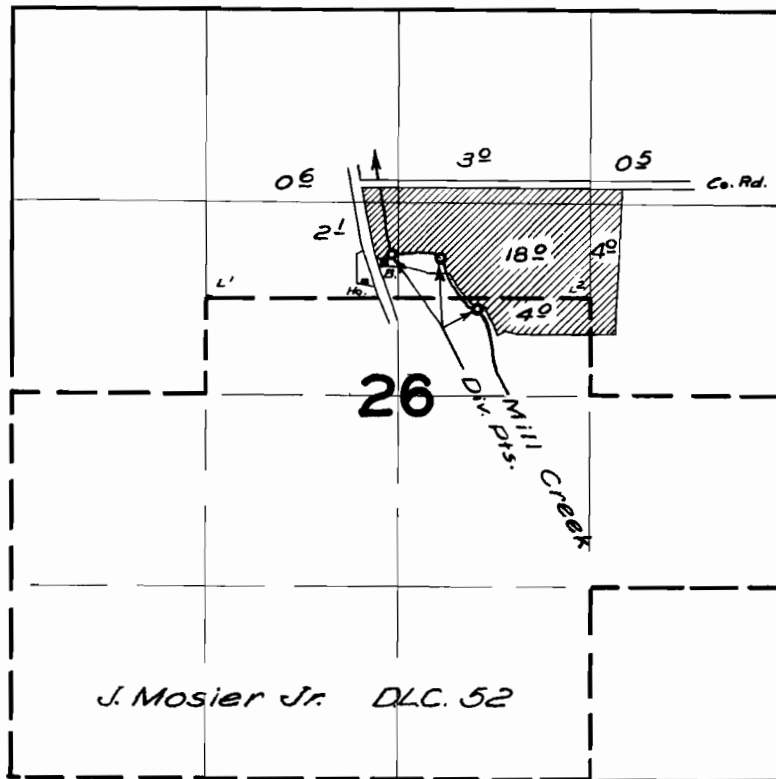

FINAL PROOF SURVEY UNDER

Application No. 27118 Permit No. 21520
IN NAME OF

Russell Nelson

Surveyed 25 July 1958, by Tr. Bish