


T. 10 S. R. 2 W.W.M.

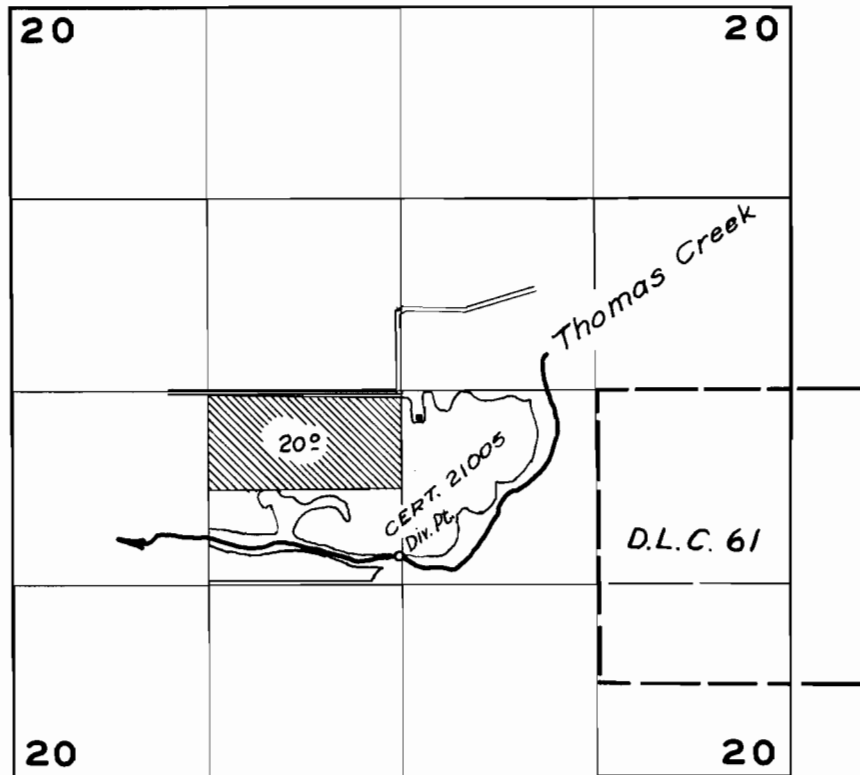

FINAL PROOF SURVEY
UNDER

Application No. 27224 Permit No. 21667
IN NAME OF

GLENN DENSMORE

Surveyed 11 July 1958, by C.O. Bartels...