


T.28 & 29 S. R.12 W. W.M.

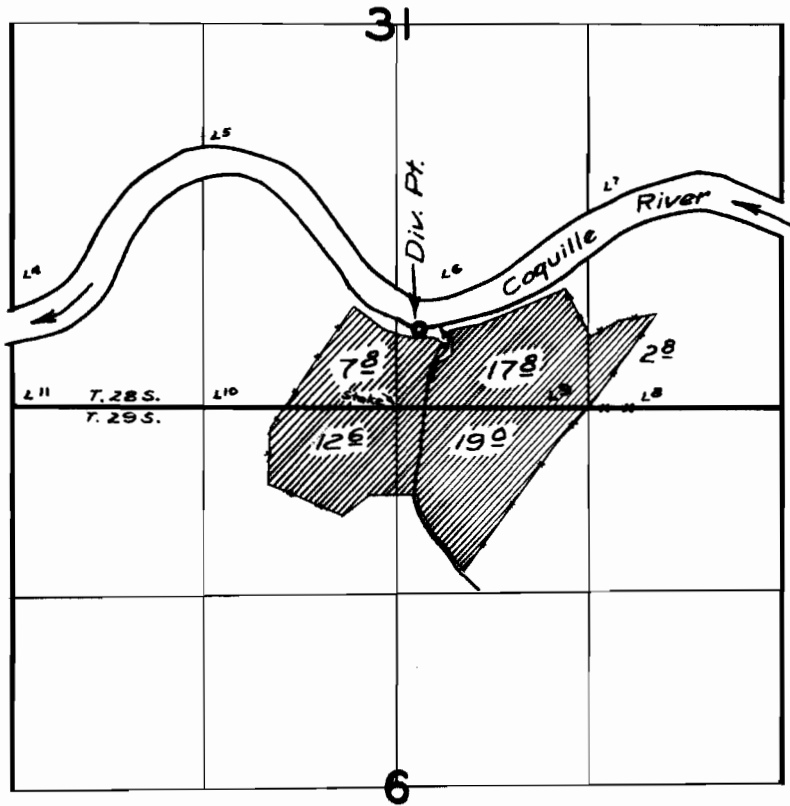

FINAL PROOF SURVEY
UNDER

Application No. 27979 Permit No. 22022
IN NAME OF

Eldred J. Leep et al.

Surveyed 23 May 1958, by Tr. Bish