


T. 1 S. R. 3 W.W.M.

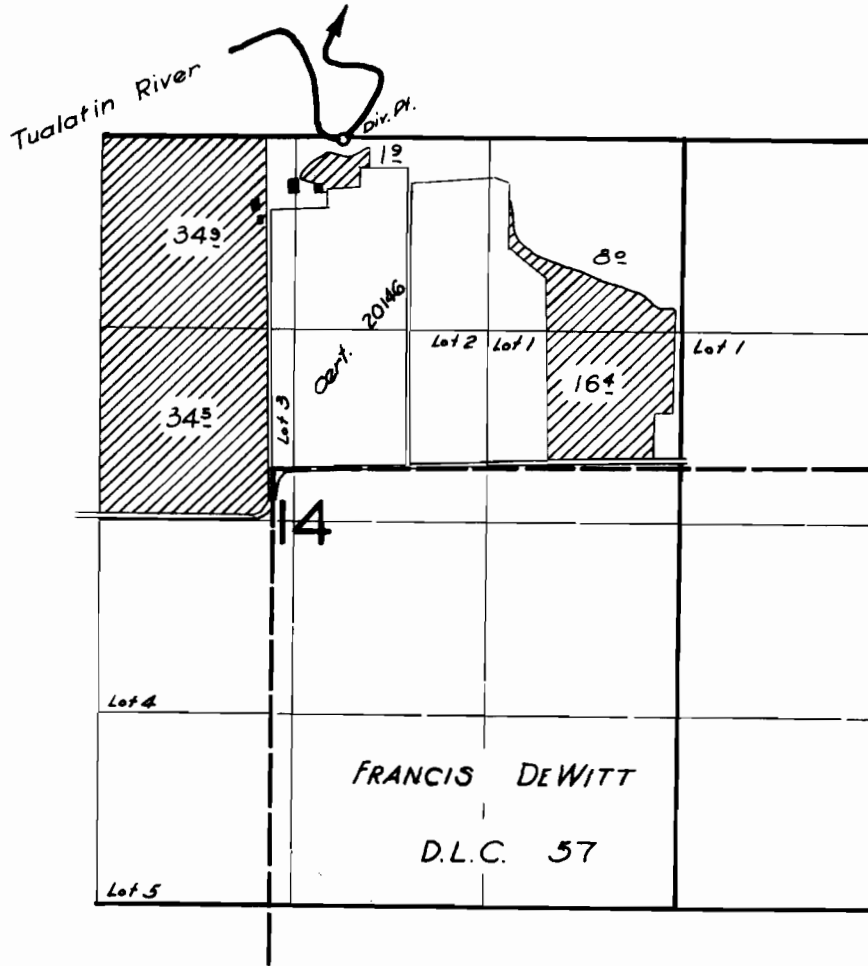

**FINAL PROOF SURVEY**  
UNDER

Application No. 28004. Permit No. 22039  
IN NAME OF

*F. H. BOWLBY AND SONS*

Surveyed 29 May 1959, by *R. Jackson*