


T. 1 S. R. 2 W. W. M.

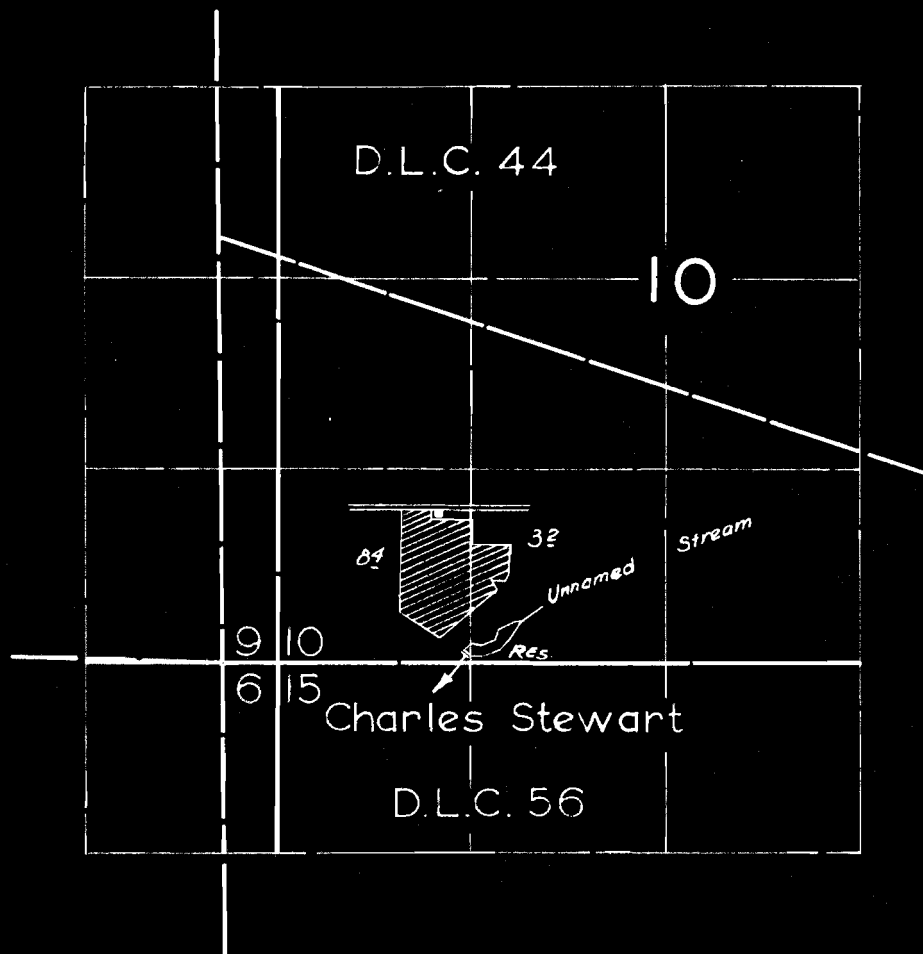

FINAL PROOF SURVEY
UNDER

Application No. *R-28166* 28167 Permit No. *R-1485* 22166
IN NAME OF

William E. Ryan

Surveyed 2 June 1959, by *R.H. Jackson*