


T.25S. R. 7 W.W.M.

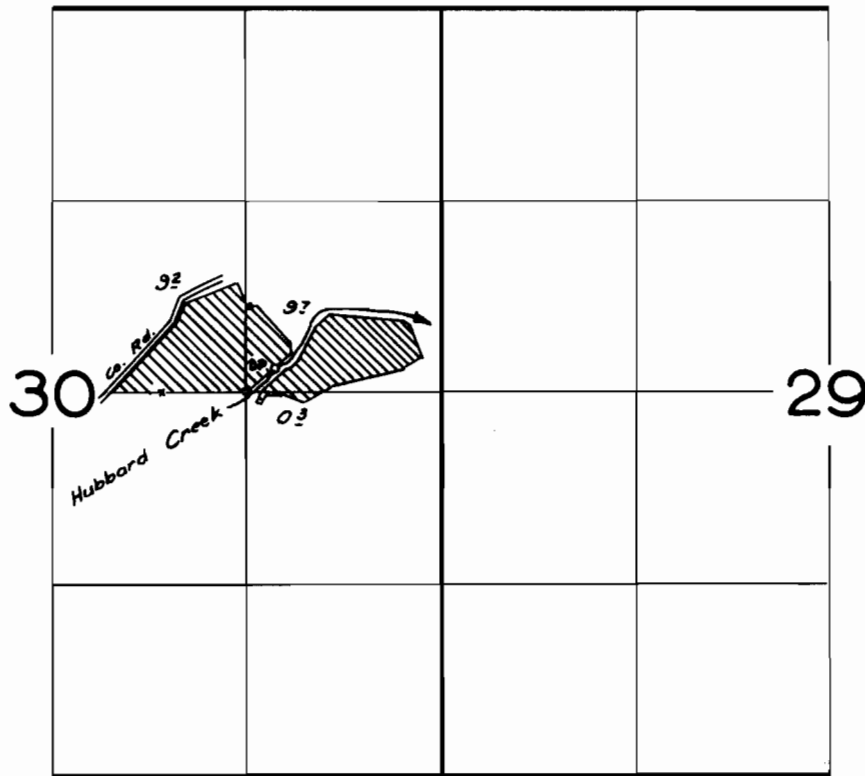

**FINAL PROOF SURVEY**  
UNDER

Application No. 28501. Permit No. 22314  
IN NAME OF

*JOHN A. ROEDER*

Surveyed June 25 1959, by *R. Jackson*