


T.I.O.S. R.I.O.W.W.M.

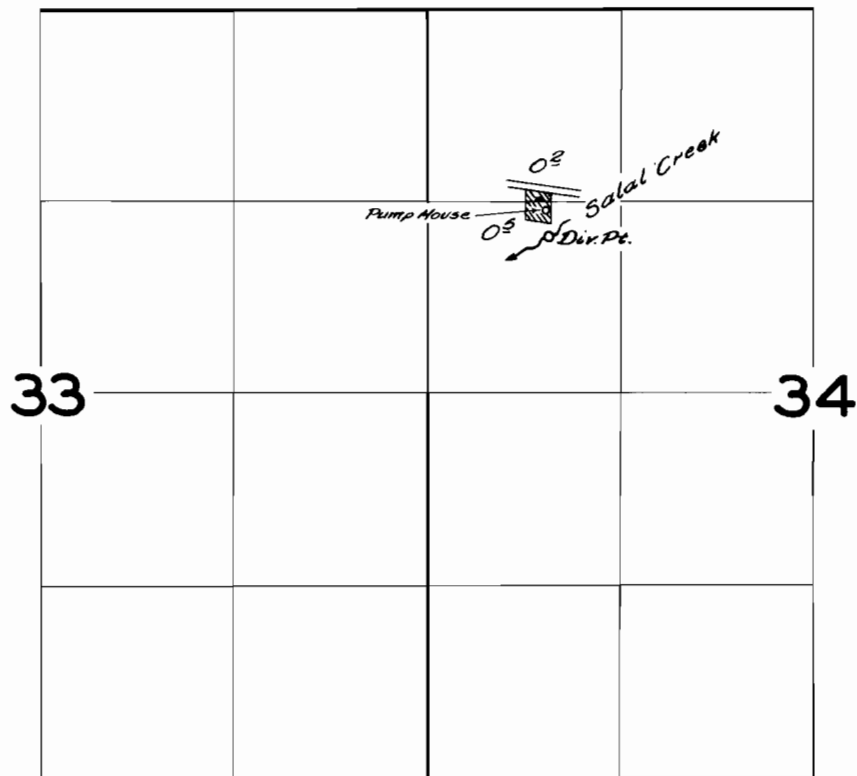

FINAL PROOF SURVEY
UNDER

Application No. 28523... Permit No. 22504...
IN NAME OF

..... *Vernon W. Johnston*

Surveyed *April 21*, 1959, by *C.D. Baile*