


T.21 S. R. 4 W.W.M.

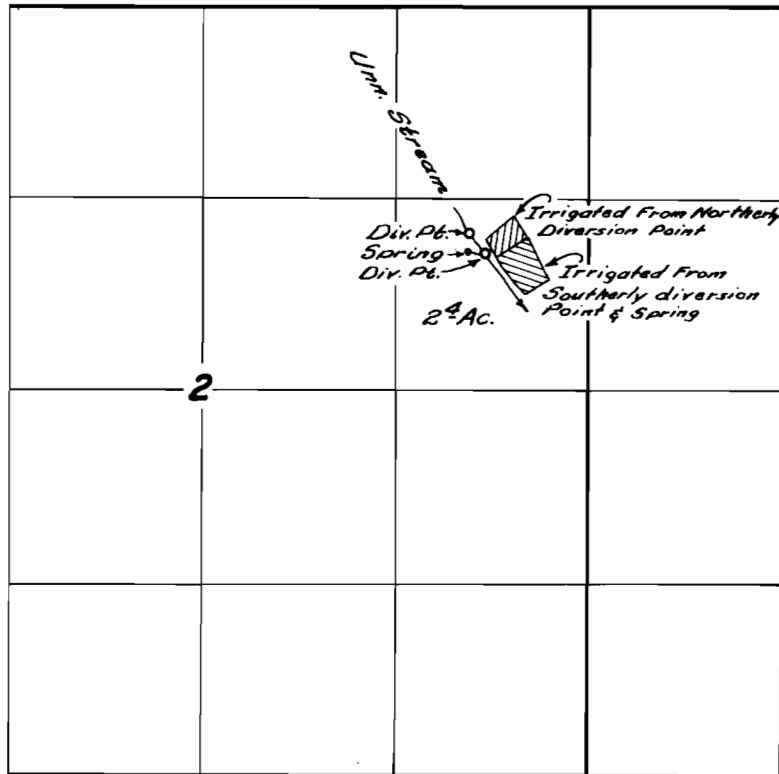

FINAL PROOF SURVEY
UNDER

Application No. *28544* Permit No. *22509*
IN NAME OF

Ivan B. & Vernece O. Williams

Surveyed *April 11, 1957* by *M. Bisk*

1957-B