


T.13 S. R. 1 W.W.M.

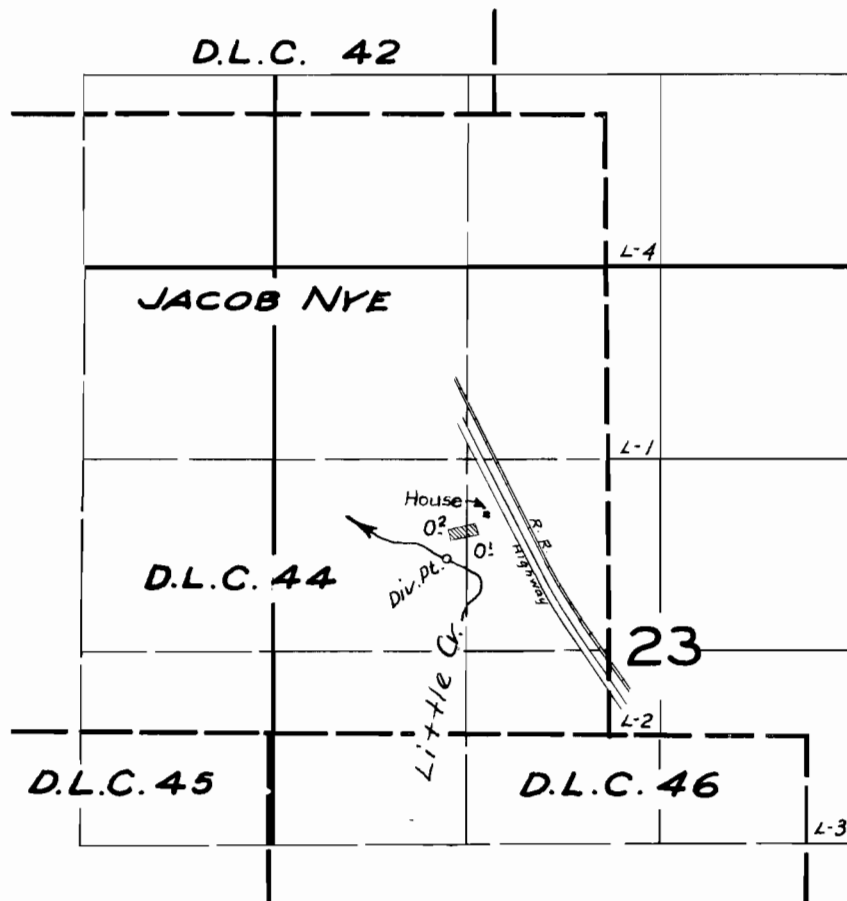

FINAL PROOF SURVEY
UNDER

Application No. 28707 Permit No. 22601
IN NAME OF

RALPH E. & MILDRED E. MYERS

Surveyed 5 Sept. 1958, by C.O. Bartels.