


T. 1 S. R. 2 W. W. M.

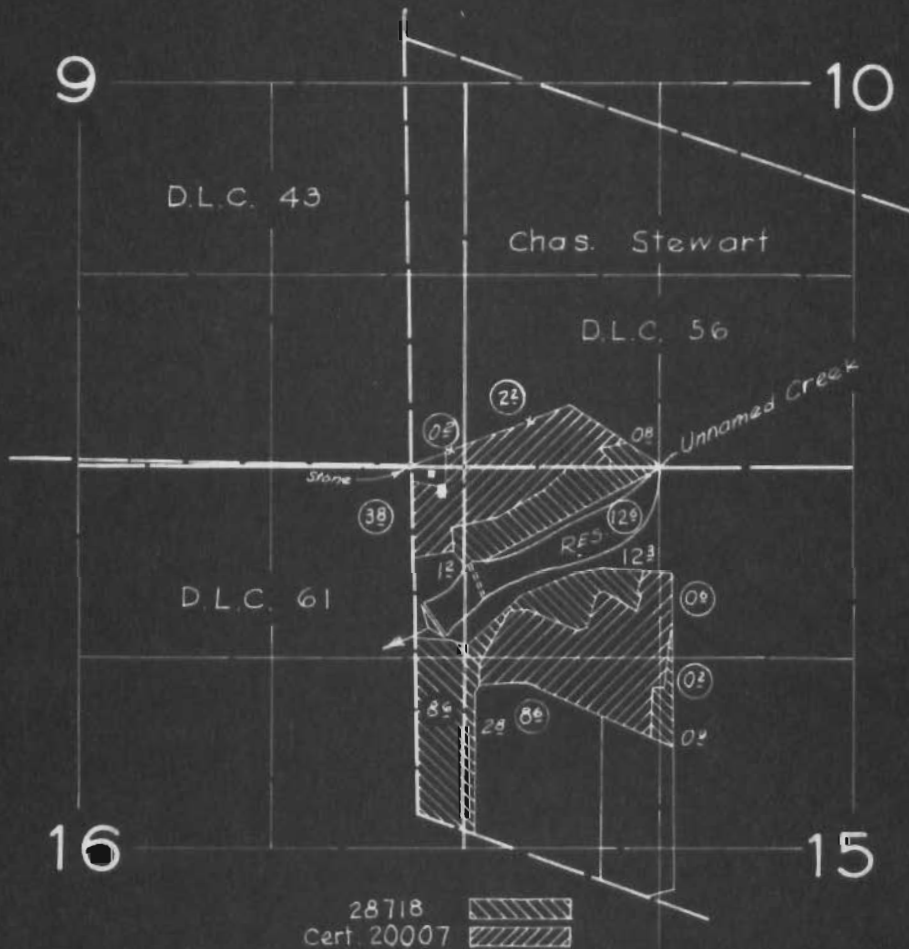

FINAL PROOF SURVEY
UNDER

R-28717 R-1570
Application No. 28718 Permit No. 22647
IN NAME OF

WILSON A. & CORRINE V. ETTINGER

Surveyed 5 June 1959, by *R. Jackson*