T. 1 S. R. 2 W.W.M.

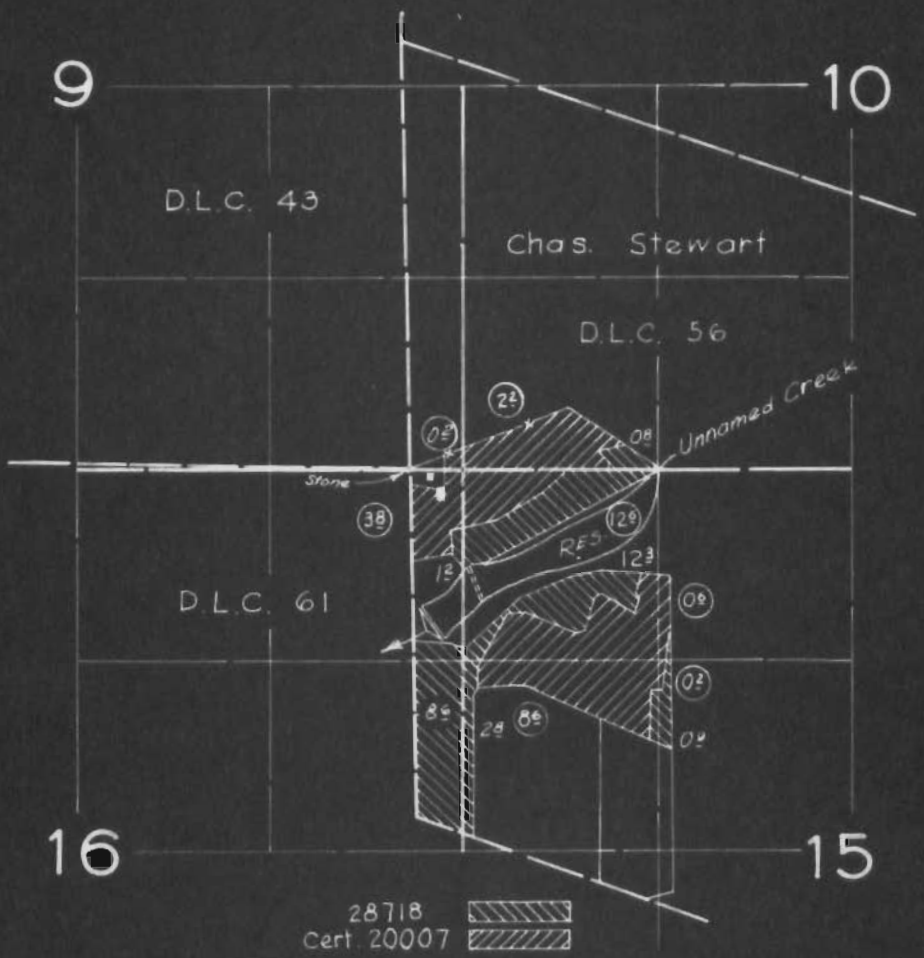

FINAL PROOF SURVEY

UNDER

Application No. R-28717 28718 Permit No. R-1570 22647

IN NAME OF

WILSON A. & CORRINE V. ETTINGER

Surveyed 5 June 1959, by R.H. Jackson

DFR-20-21 : 1959-0