


T.36S.R.7W.W.M.

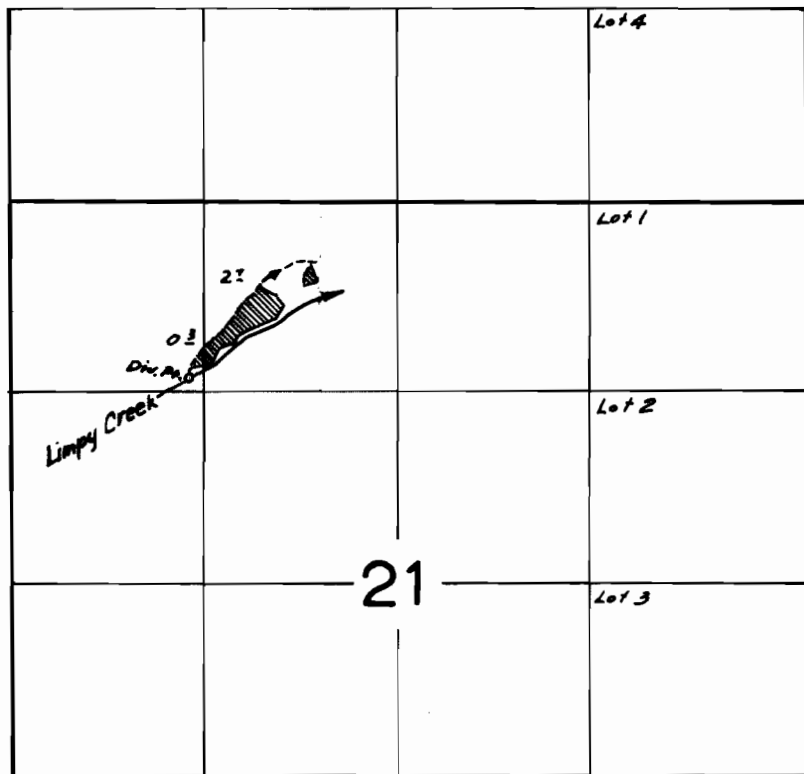

FINAL PROOF SURVEY
UNDER

Application No. 28791 Permit No. 22662
IN NAME OF

J. Z. & PHILA E. WALKER

Surveyed July 24, 1959, by R. Jackson