


# T. I N. R. I W. W. M.

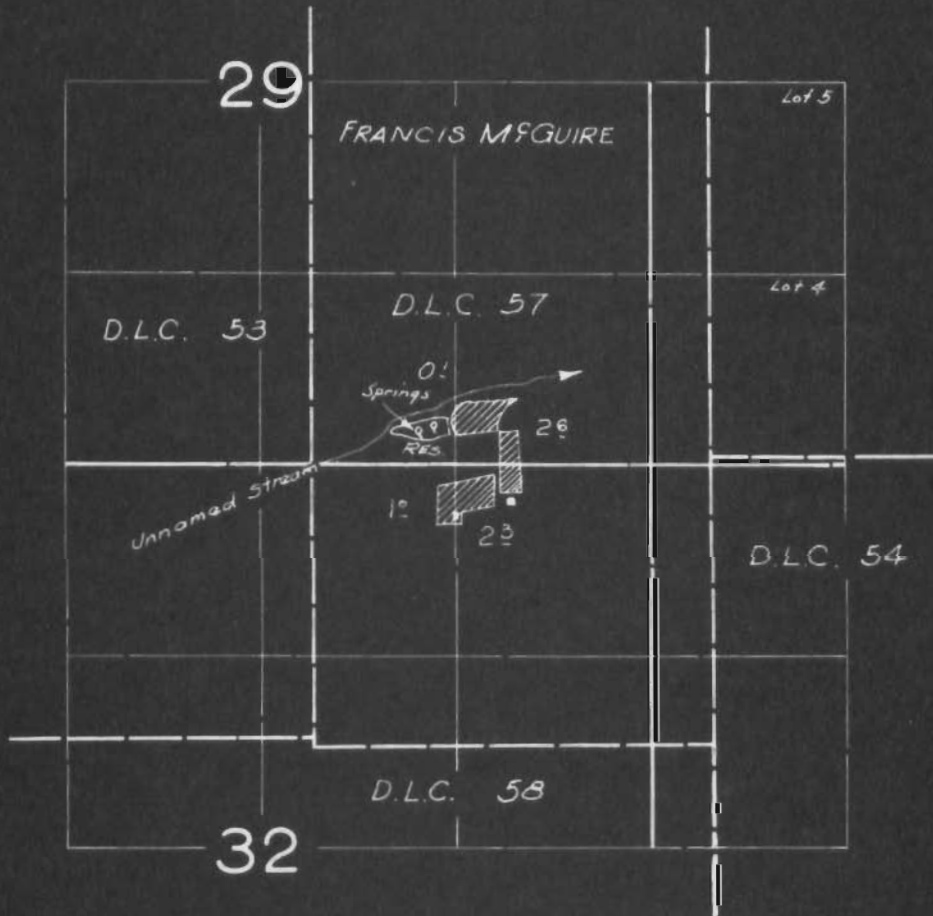

## FINAL PROOF SURVEY UNDER

Application No. *R-28661* 28662 Permit No. *R-1590* 22741  
IN NAME OF

*VAHAN M. DINIHANIAN*

Surveyed *1 June* 1959, by *D.H. Jackson*