


T. 1 S. R. 3 W. W. M.

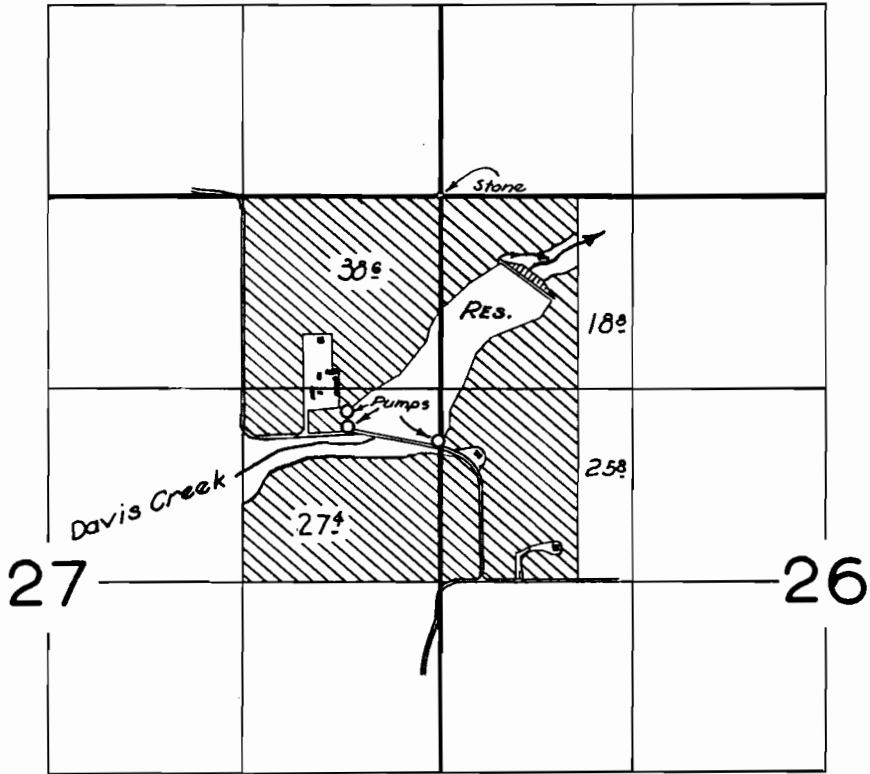

FINAL PROOF SURVEY UNDER

Application No. *R-28557* 28558.. Permit No. *R-1589* 22803..
IN NAME OF

JOSEPH DOBER

Surveyed *26 May 1959*, by *RH Jackson*