


T.15 S. R. 12 W.W.M.

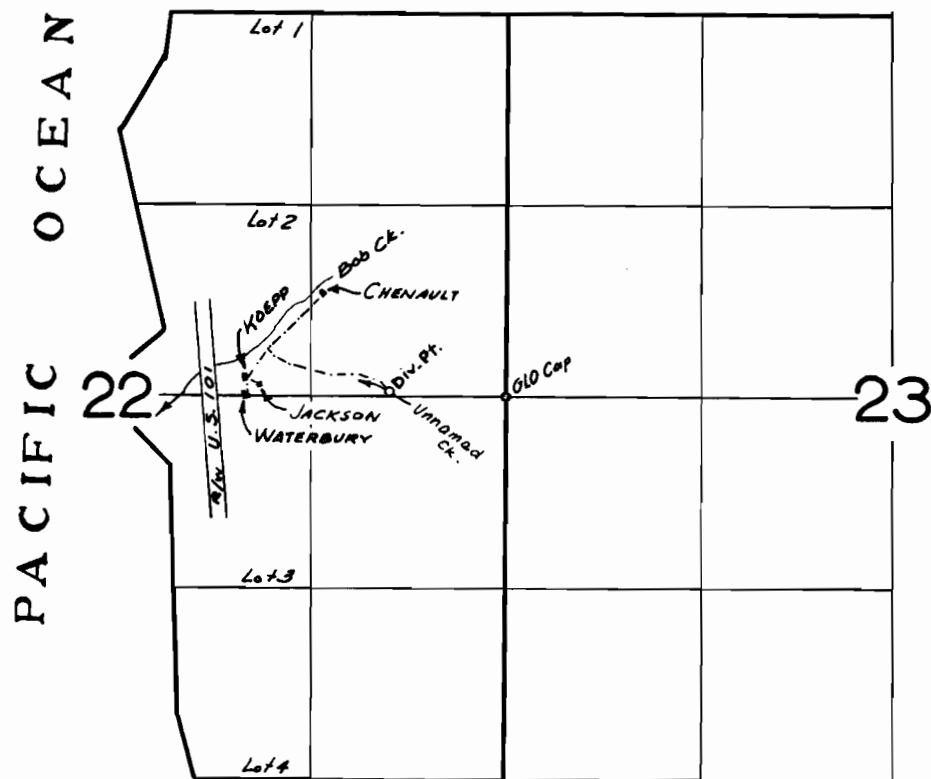

FINAL PROOF SURVEY
UNDER

Application No. 29086 Permit No. 22871
IN NAME OF

RAY KOEPP, DON W. WATERBURY & W.H. WATERBURY

Surveyed April 8 1959, by *R. Jackson*