


T. 19 S. R. 11 W. W.M.

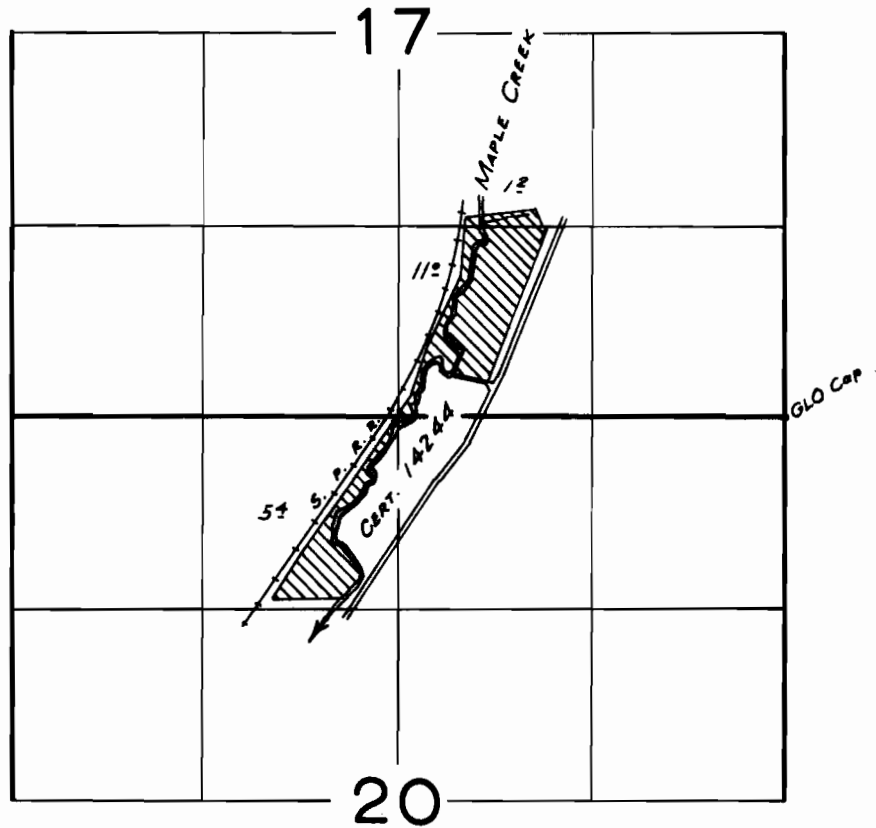

FINAL PROOF SURVEY
UNDER

Application No. 28643. Permit No. 22897.
IN NAME OF

FRANCIS E. AUSTIN

Surveyed April 6, 1959, by *R. Jackson*