


T.11S. R. 7 W.W.M.

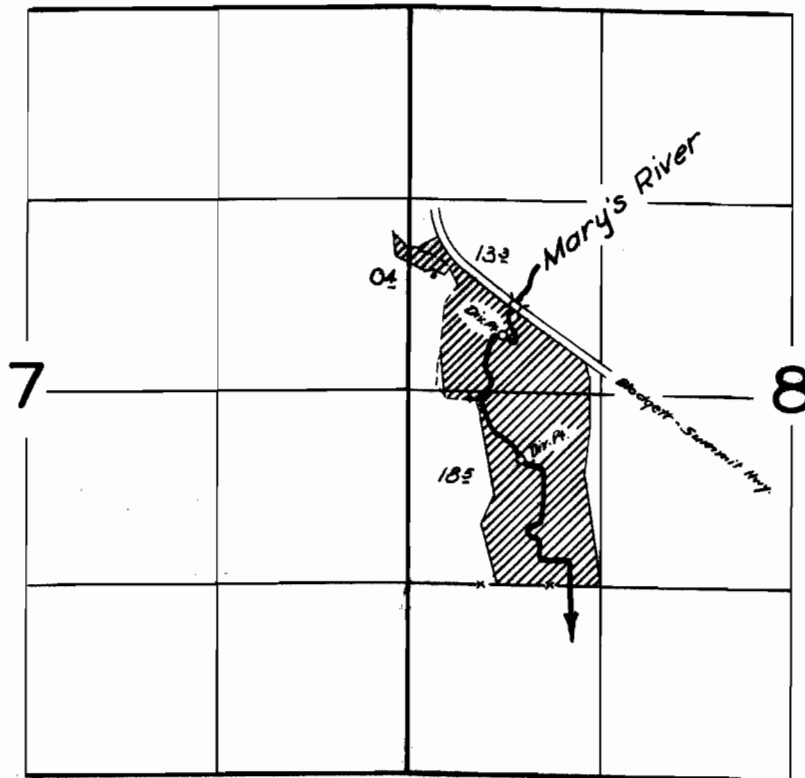

**FINAL PROOF SURVEY**  
UNDER

Application No. 29175..... Permit No. 22941.....  
IN NAME OF

*MARTIN HARMSSEN*

Surveyed *7 March 1959*, by *R.H. Jackson*