


T. 22 S. R. 3 W. W. M.

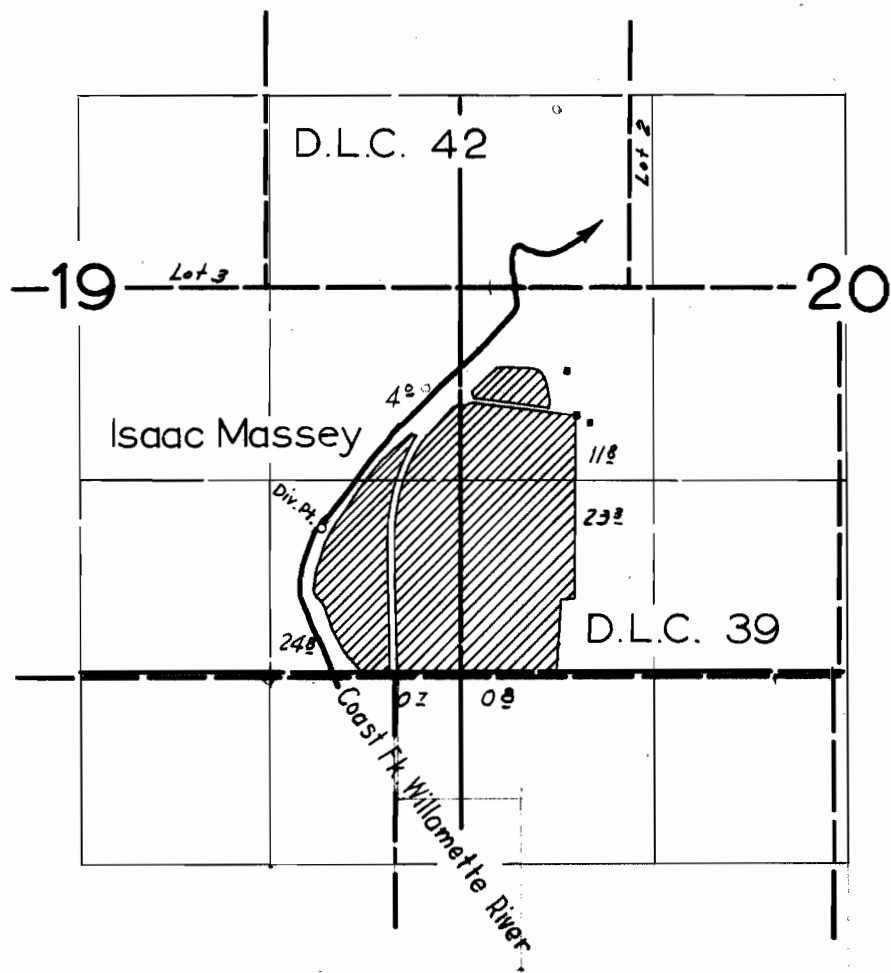

FINAL PROOF SURVEY
UNDER

Application No. 29212 Permit No. 23000
IN NAME OF

MERLE M. & CLARICE R. MOORE

Surveyed Mar. 24 1959, by R. Jackson