


T.13 S. R.1 E.W.M.

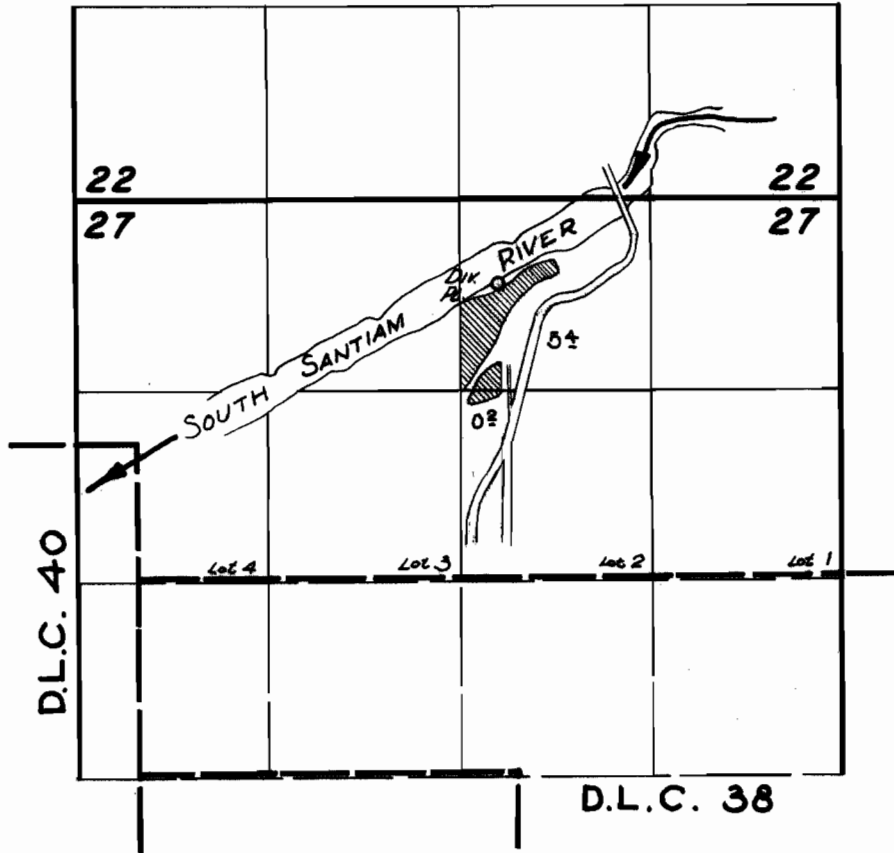

FINAL PROOF SURVEY
UNDER

Application No. 29257. Permit No. 23011...
IN NAME OF

LESTER & GLADYS F. WELD

Surveyed 5 Sept. 1958, by C.O. Bartels.