


T. 26 S. R. 6 W. W.M.

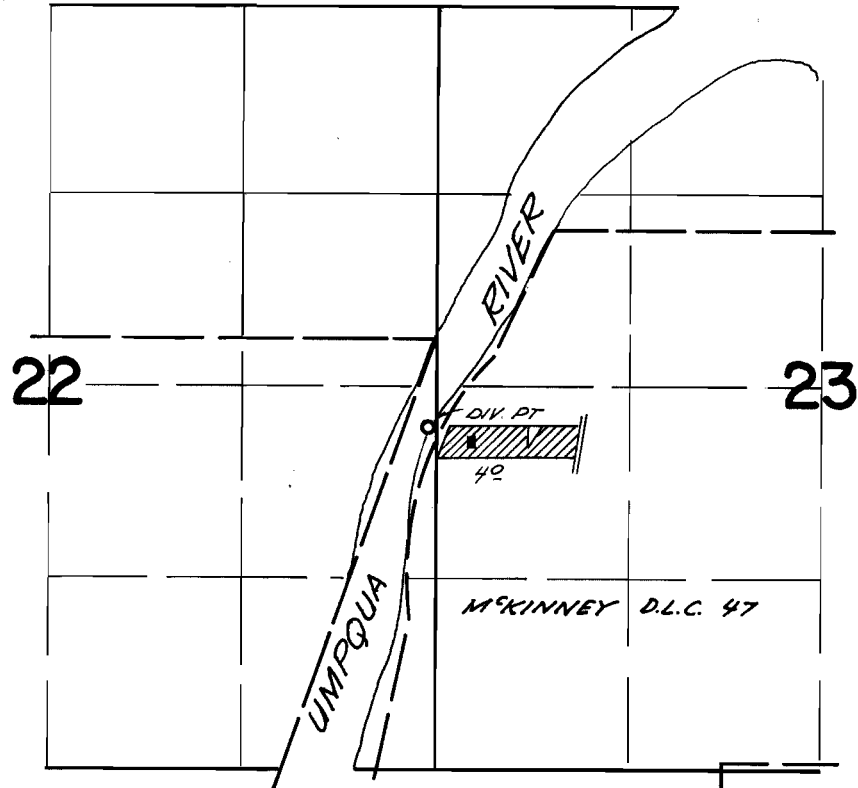


**FINAL PROOF SURVEY**  
UNDER

Application No. 29290. Permit No. 23024.  
IN NAME OF

*GRADY and ALICE MANKINS*

Surveyed *June 25 1959*, by *R.H. JACKSON*.

T. 26 S. R. 6 W. W. M.

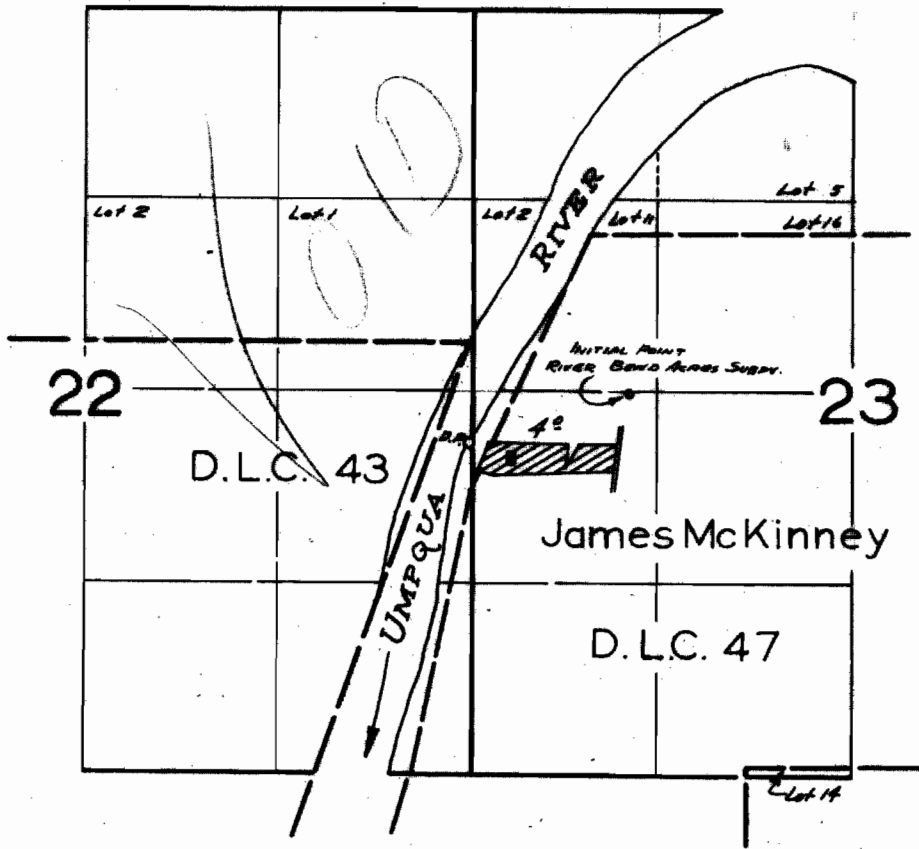

**FINAL PROOF SURVEY**  
UNDER

Application No. 29290. Permit No. 23024  
IN NAME OF

GRADY & ALICE MANKINS

Surveyed June 25 1959, by R. H. Jackson