


T.24 S.R.11 W.W.M.

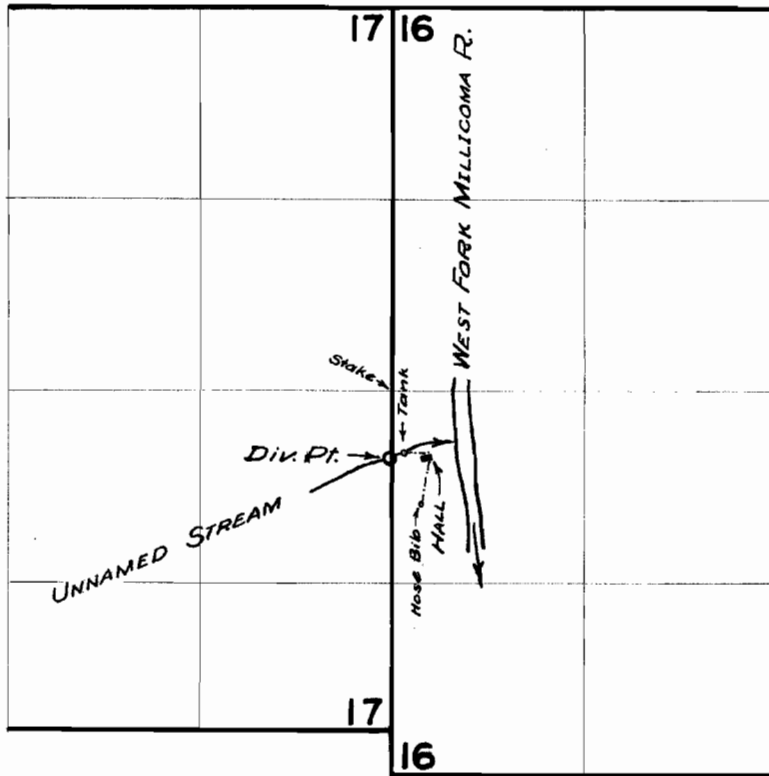

**FINAL PROOF SURVEY**  
UNDER

Application No. 29220. Permit No. 23072.  
IN NAME OF

..... *CAMP MILLICOMA, INC.* .....

Surveyed *17 July*, 1958, by *M. Bish*.....