


T.14S. R.1W.W.M.

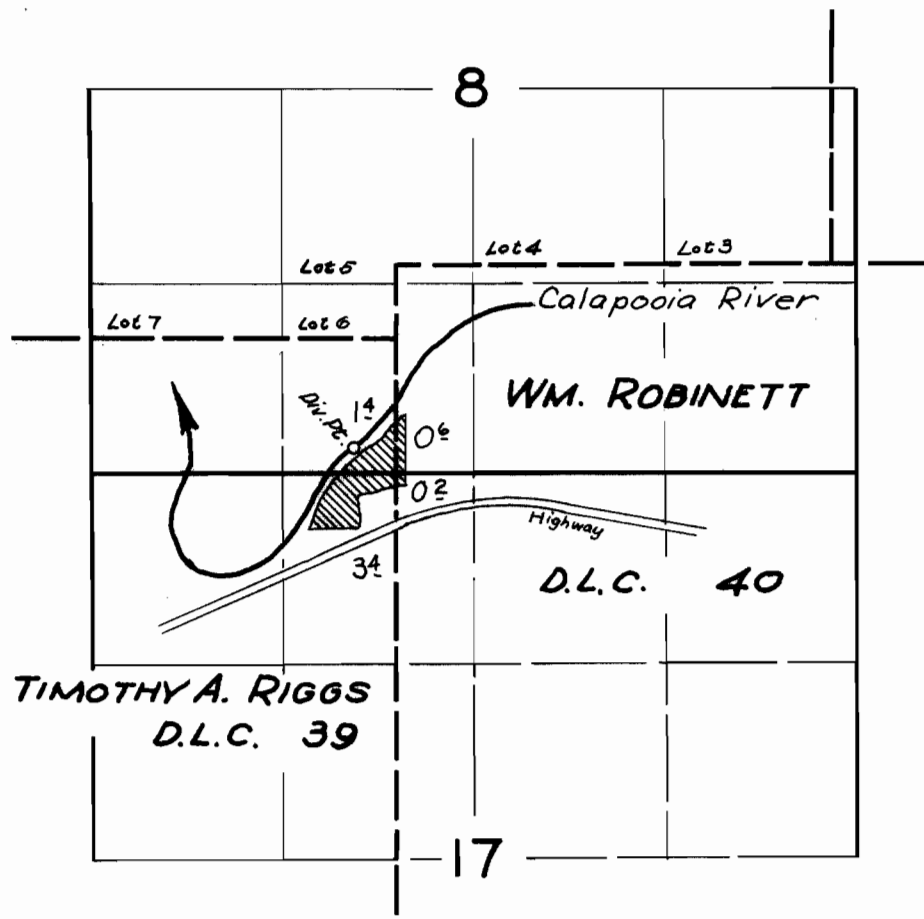

FINAL PROOF SURVEY
UNDER

Application No. 29242.. Permit No. 23119
IN NAME OF

RAY KYHL

Surveyed 8 Sept. 1958, by C.O. Bartels