


T.37S.R.14 & 15W.W.M.

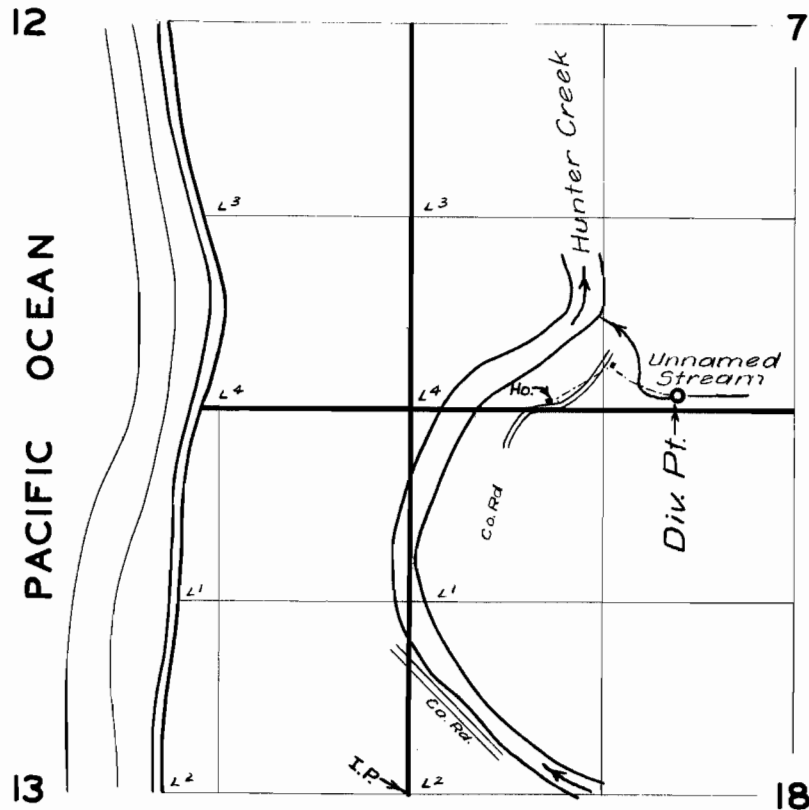

FINAL PROOF SURVEY
UNDER

Application No. 29543 Permit No. 23212
IN NAME OF

Raymond R & Margaret K. Leforty

Surveyed 26 Mar. 1958, by M. Bieh