


T.14S. R.1W.W.M.

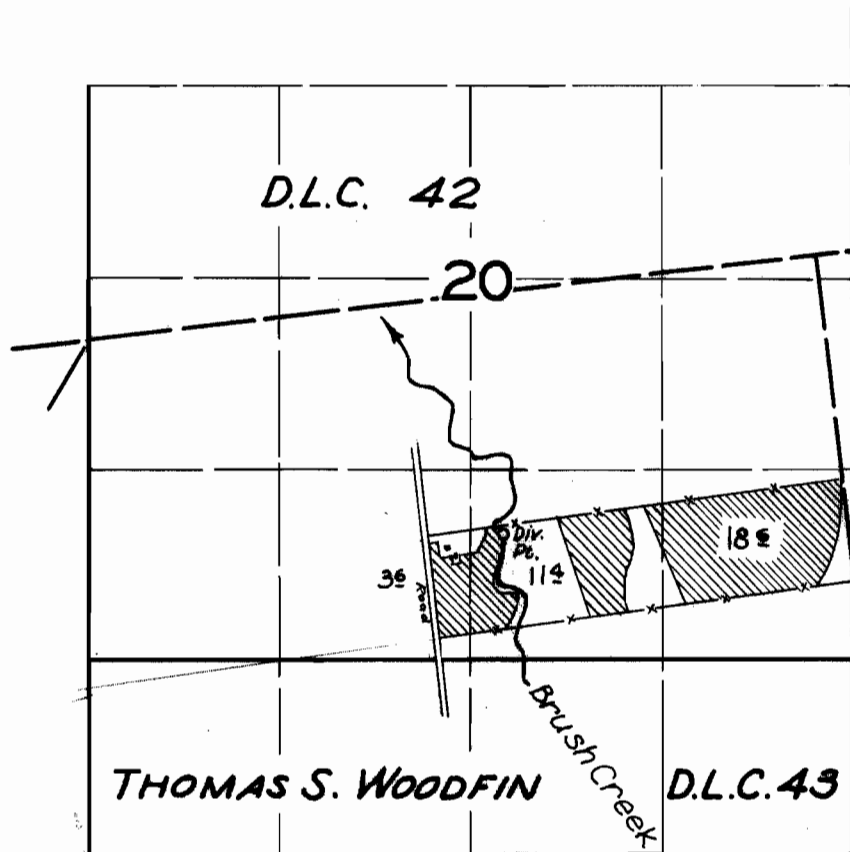

**FINAL PROOF SURVEY**  
UNDER

Application No. 29539... Permit No. 23277..  
IN NAME OF

**WILLIS N. & STELLA J. NYBERG**

Surveyed 8 Sept. 1958, by C.O. Bartels...