


T. 3S. R. 2E. W.M.

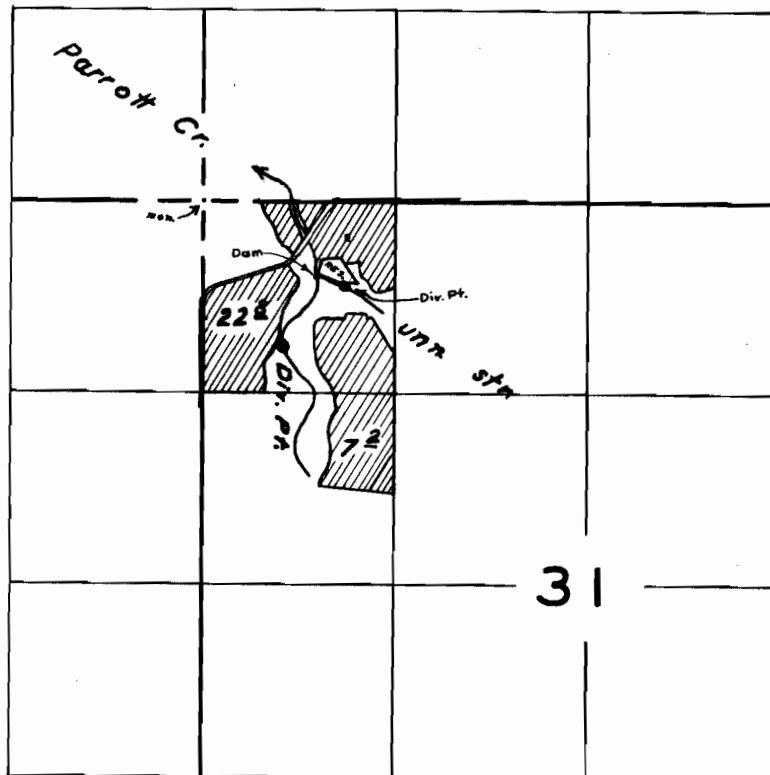

FINAL PROOF SURVEY
UNDER

R-29793 R-1711
Application No. 29365 Permit No. 23332
IN NAME OF

Ross R. Mitchell

Surveyed July 11, 1958 by W.H. Perry