


T. 37 S. R. 1 W. W. M.

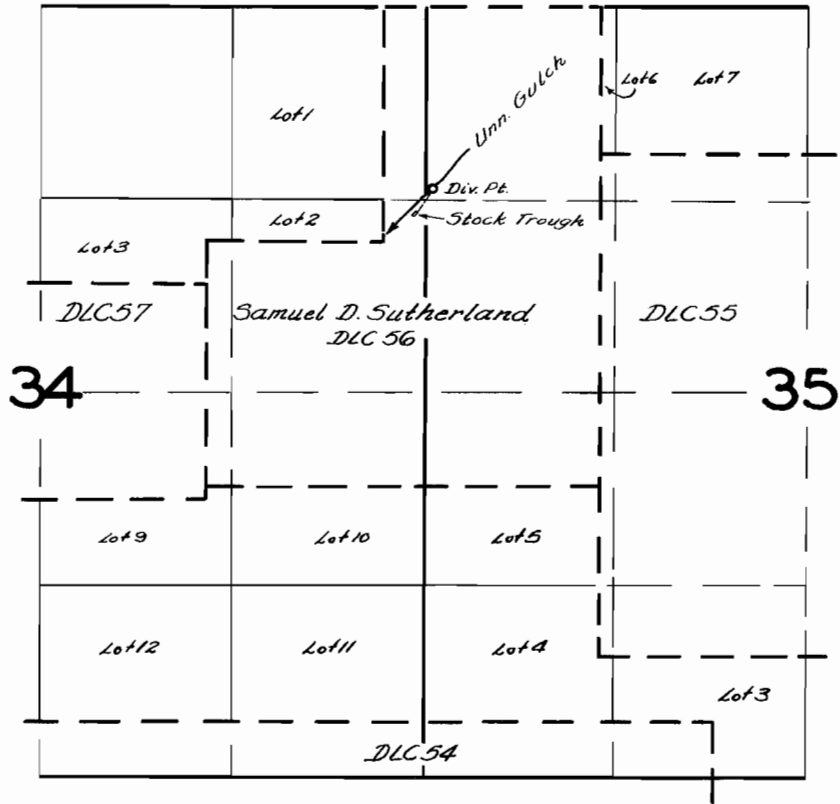

FINAL PROOF SURVEY
UNDER

Application No. 29630 Permit No. 23341
IN NAME OF

S. E. Hansen

Surveyed May 19, 1959, by C. O. Bartels