


T.10S.R.4 & 5W.W.M.

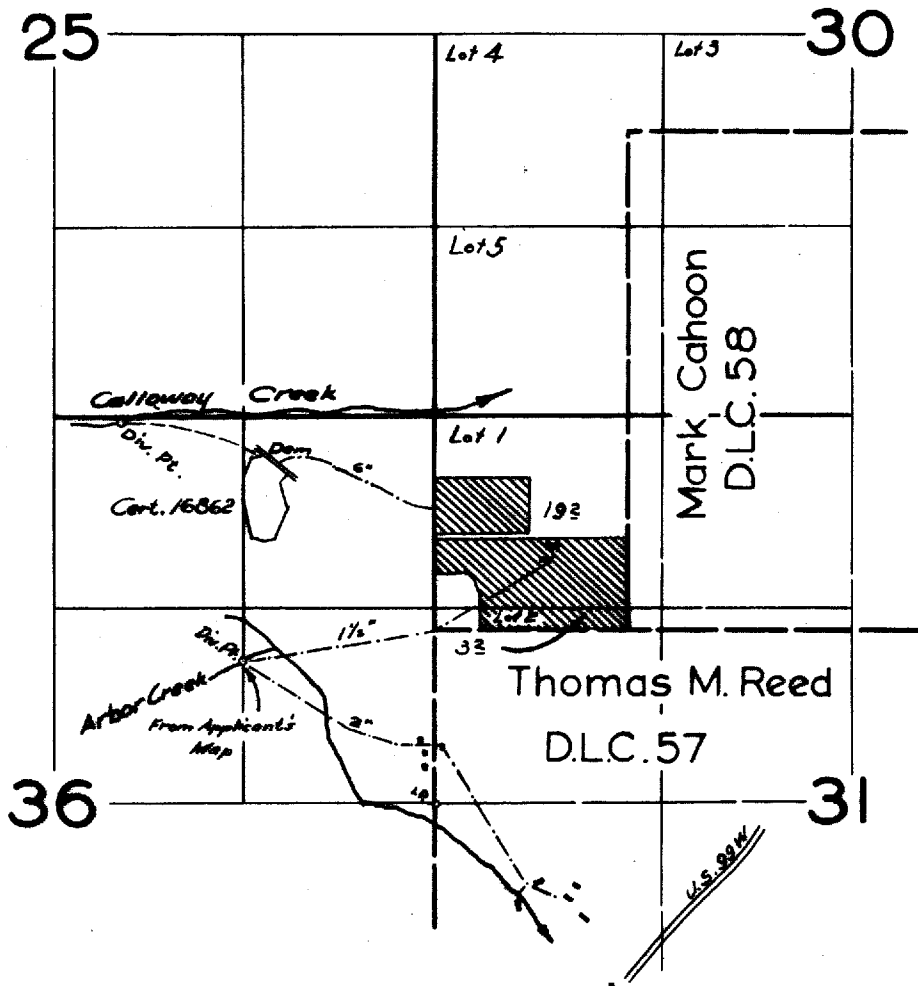

FINAL PROOF SURVEY
UNDER

Application No. 29044 Permit No. 23591
IN NAME OF

STATE OF OREGON, BOARD OF FORESTRY

Surveyed 10 March 1959, by R. H. Jackson