


T. 3 S. R. 3 E. W.M.

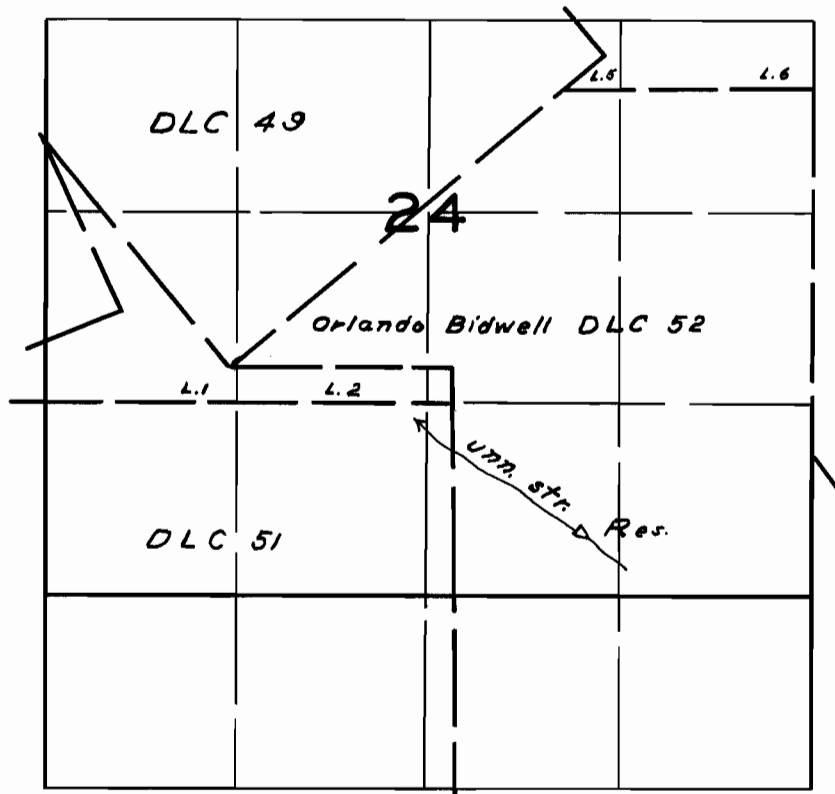

FINAL PROOF SURVEY
UNDER

R-29957 *R-1749*
Application No. *29958* Permit No. *23599*
IN NAME OF

Oliver S. C. Gerber

Surveyed *Aug. 27, 1958*, by *W.N. Perry*