


T. 3 S. R. 3 E. W.M.

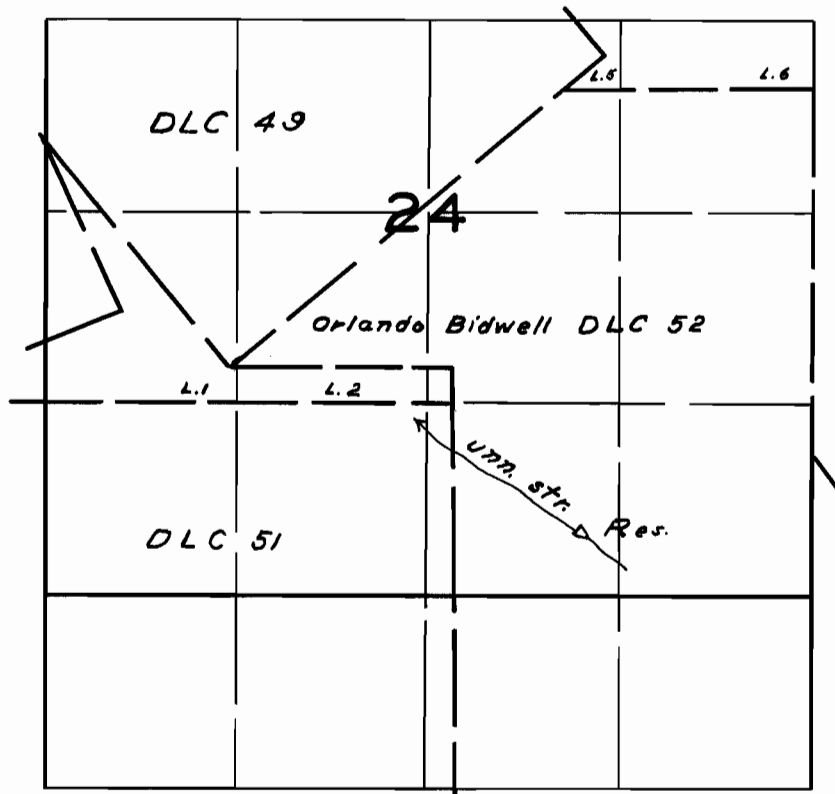

**FINAL PROOF SURVEY**  
UNDER

R-29957 R-1749  
Application No. 29958 Permit No. 23599  
IN NAME OF

Oliver S. C. Gerber

Surveyed Aug. 27, 1958, by W.N. Perry