


T. 2-3N. R. 3W.W.M.

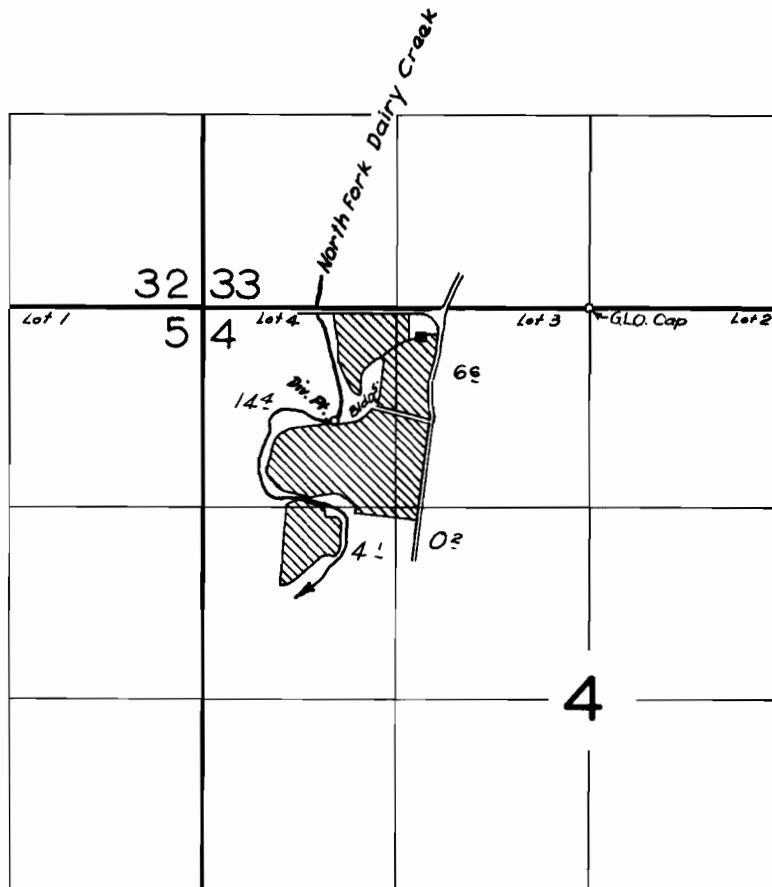

FINAL PROOF SURVEY
UNDER

Application No. 29967 Permit No. 23608
IN NAME OF

VERN RAW ENTERPRISES, INC.

Surveyed 28 May 1959, by R. Jackson