


T. 1N. R. 3W.W.M.

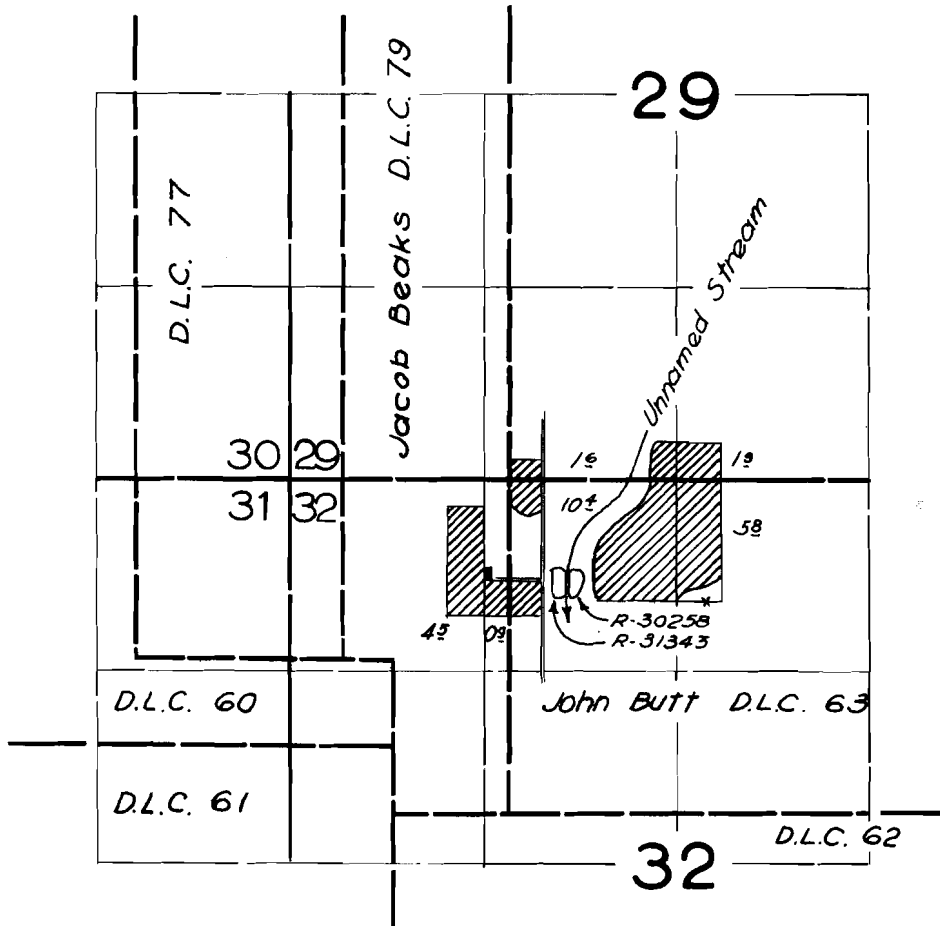

FINAL PROOF SURVEY

UNDER

R-30258
30259
R-31343

R-1756
23657
R-1984

Application No. 31344 Permit No. 24699

IN NAME OF

EDWARD C. & DOROTHY PORTER

Surveyed 3 June 1959, by *R. Jackson*