


# T.9S. R.1E.W.M.

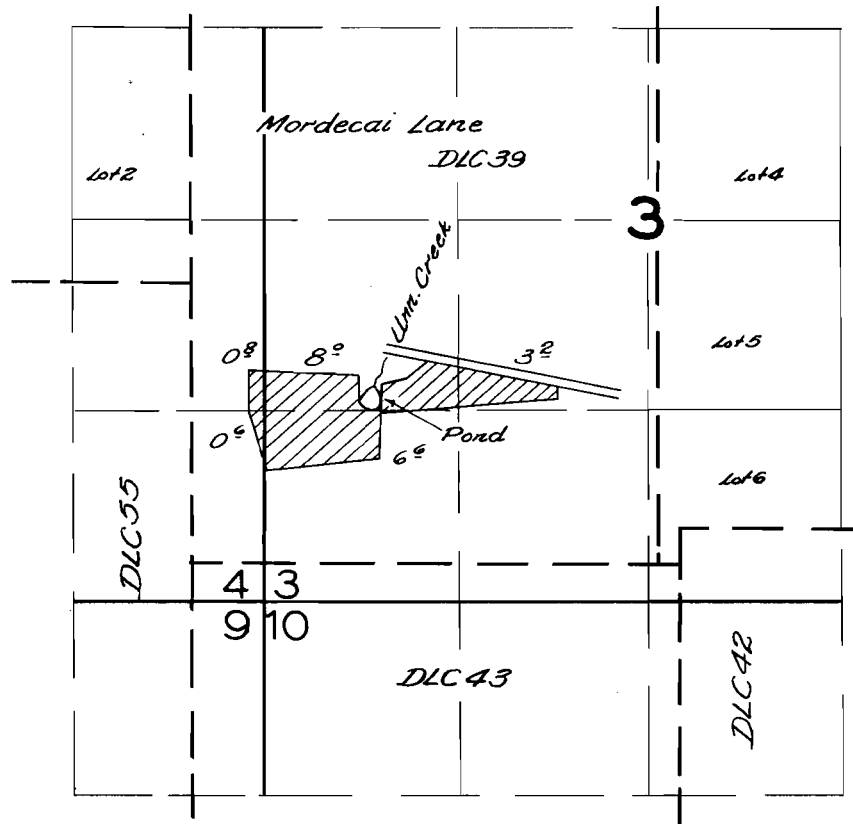

Map Copy  
from  
30331

## FINAL PROOF SURVEY UNDER

R-30330 R-1757  
Application No. 30331 Permit No. 23658  
IN NAME OF

TED ETZEL

Surveyed April 27 1959, by *W. B. [Signature]*