


T.9S. R.1E.W.M.

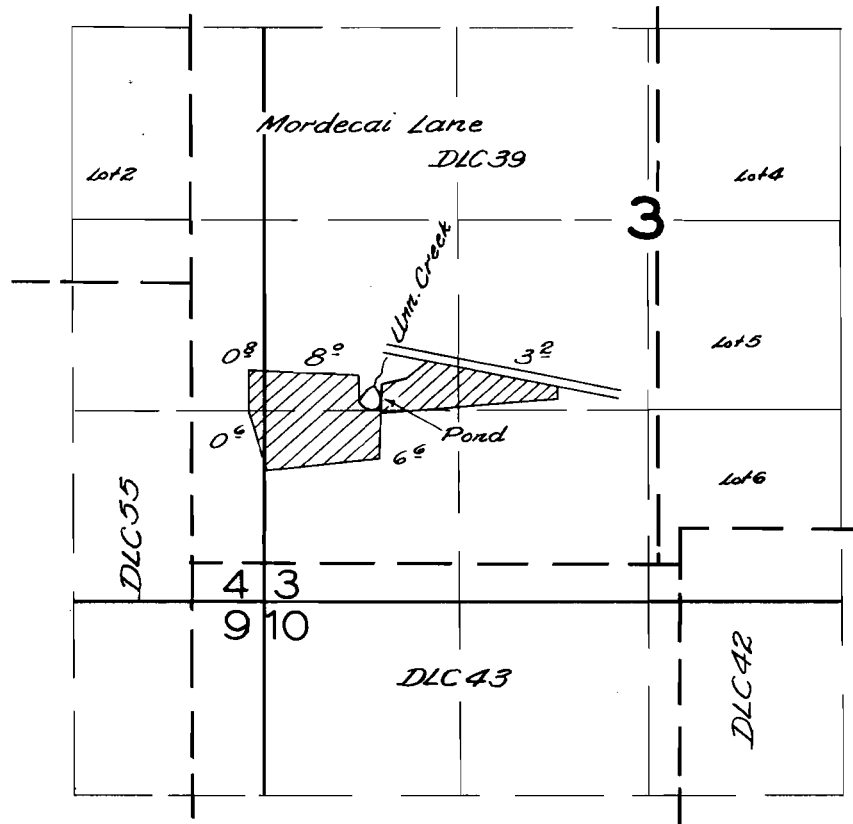

FINAL PROOF SURVEY UNDER

R-30330 R-1757
Application No. 30331 Permit No. 23658
IN NAME OF

TED ETZEL

Surveyed April 27 1959, by *W. B. [Signature]*