


# T.34-35 S. R.5 W.W.M:

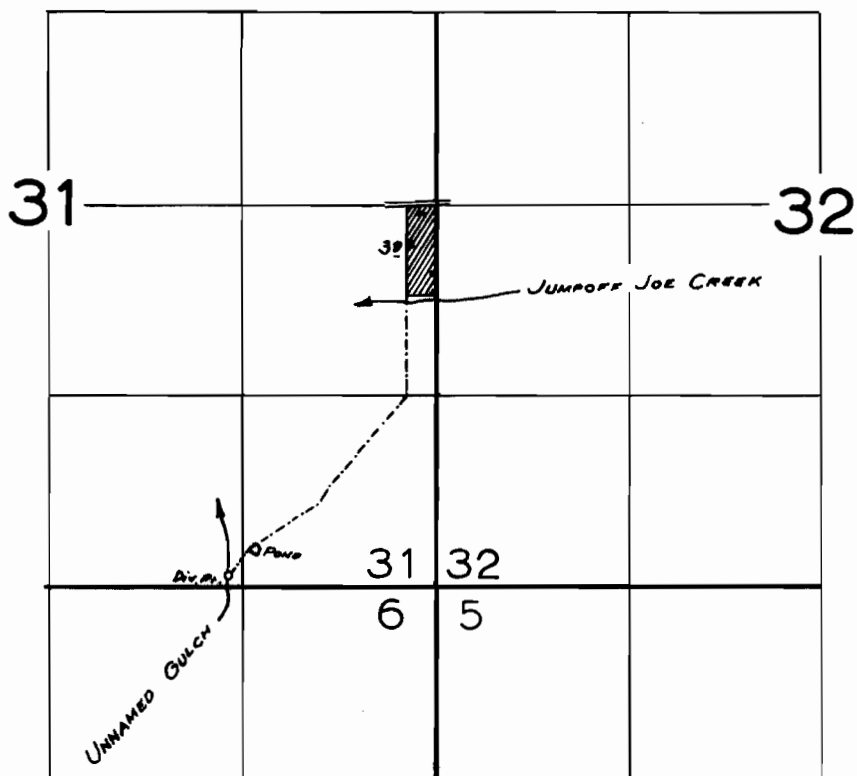

## FINAL PROOF SURVEY UNDER

Application No. 30047 Permit No. 23692  
IN NAME OF

CARL HUSEN

Surveyed July 16 1959, by R. Jackson