


T.4S. R.2E. W.M.

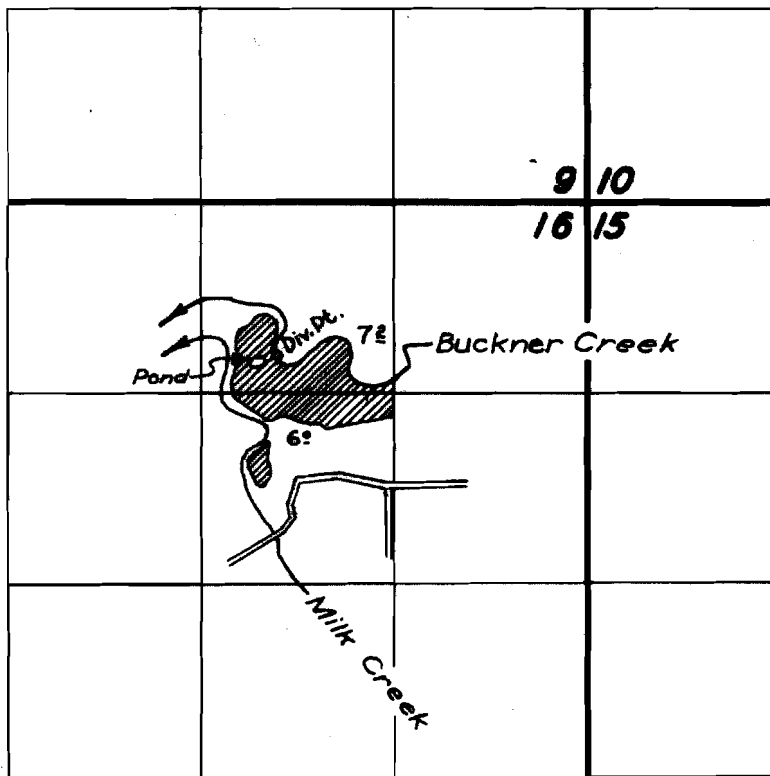

FINAL PROOF SURVEY
UNDER

Application No. 30333... Permit No. 23951...
IN NAME OF

J. M. HUDSPETH

Surveyed 14 August 1956, by C.O. Bartels.