


T. 1 S. R. 2 W. W. M.

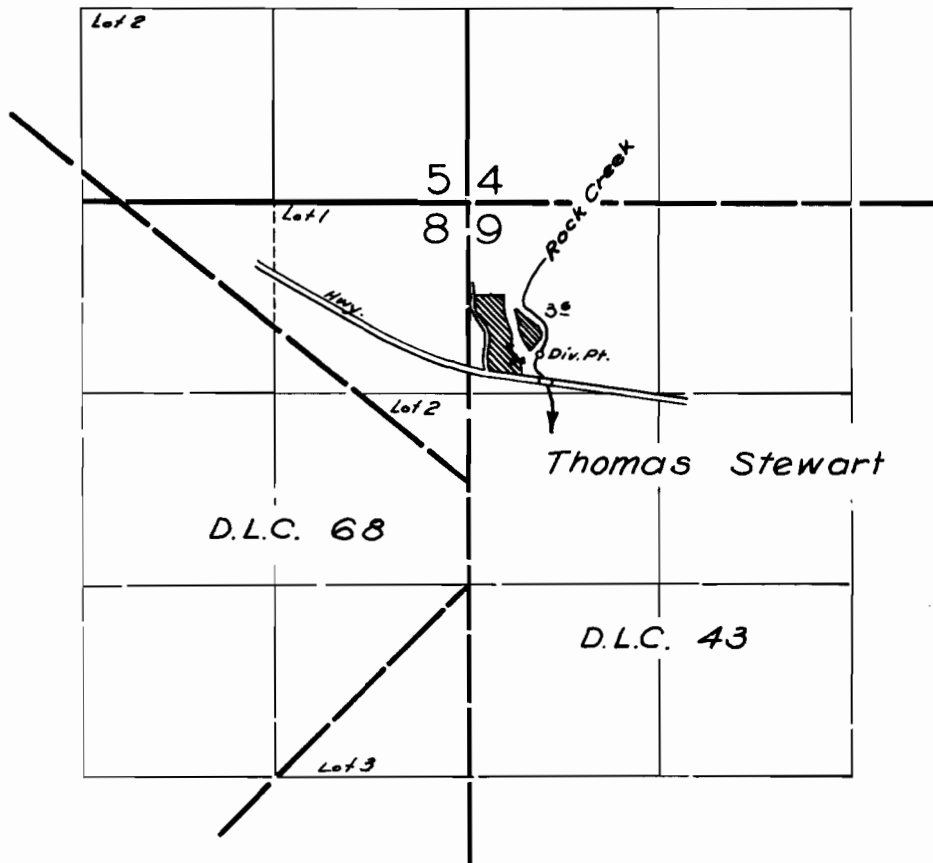

FINAL PROOF SURVEY
UNDER

Application No. 30573. Permit No. 24084
IN NAME OF

ALVIN M. BATCHELAR

Surveyed 3 June 1959, by *R. Jackson*